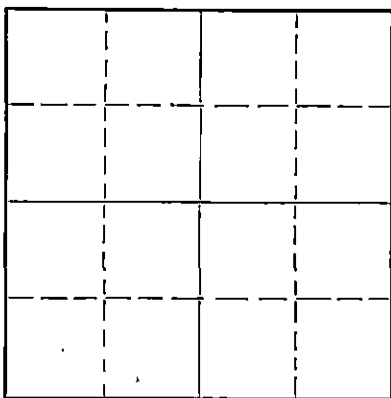


Give All Information Completely
Make Required Affidavit
Mail or Deliver Report to:
Conservation Division
State Corporation Commission
800 Bittling Building
Wichita, Kansas

15-185-01001-0000
WELL PLUGGING RECORD

NORTH

Locate well correctly on above
Section Plot

Stafford County. Sec. 18 Twp. 25 Rge. 12W (E) (W)
Location as "NE/CNW/SW" or footage from lines NE 1/4 NE 1/4 NE 1/4
Lease Owner Robert Carnahan et al.
Lease Name McCune Well No. 1
Office Address Broadview Hotel, Wichita, Kansas.
Character of Well (completed as Oil, Gas or Dry Hole) Dry
Date well completed July 27, 1951 19.
Application for plugging filed July 28, 1951 19.
Application for plugging approved 19.
Plugging commenced July 27, 1951 19.
Plugging completed July 27, 1951 19.
Reason for abandonment of well or producing formation
Dry
If a producing well is abandoned, date of last production 19.
Was permission obtained from the Conservation Division or its agents before plugging was commenced? Yes

Name of Conservation Agent who supervised plugging of this well.

Producing formation Depth to top Bottom Total Depth of Well 4210 Feet

Show depth and thickness of all water, oil and gas formations.

OIL, GAS OR WATER RECORDS

CASING RECORD

Formation	Content	From	To	Size	Put In	Pulled Out
				8-5/8"	296'	None

Describe in detail the manner in which the well was plugged, indicating where the mud fluid was placed and the method or methods used in introducing it into the hole. If cement or other plugs were used, state the character of same and depth placed, from feet to feet for each plug set.

Bottom Bridge Plug pushed to 260' - Rock on top of plug - Halls on top of rock, then 15 sacks cement on top of hells put in through pipe. Hole bridged again at 40 ft. with tree limbs, rock and hells, 10 sacks cement on top of Bridge to bottom of cellar. Pipe cut off 3 ft. below surface.

(If additional description is necessary, use BACK of this sheet)

Correspondence regarding this well should be addressed to Aylward Drilling Company
Address 813 First National Bank Building, Wichita, Kansas

STATE OF KANSAS, COUNTY OF SEDGWICK, ss.

N. W. AYLWARD (employee of owner) or (owner or operator) of the above-described well, being first duly sworn on oath, says: That I have knowledge of the facts, statements, and matters herein contained and the log of the above-described well as filed and that the same are true and correct. So help me God.

(Signature)

410 East Fourth, Hoisington, Kansas.
(Address)

SUBSCRIBED AND SWORN to before me this 28th day of July 1951

My commission expires July 9, 1952.

22-7377-8

4-49-10M

PLUGGING
FILE SEC 18 T 25 R 12W
BOOK PAGE 28 LINE 36

15-185-01001-0000

McCUNE WELL NO. 1

Casing Record:

8-5/8" - 296'

Company: Aylward Drilling Co. & Others
Contractor: Aylward Drilling Company

Commenced: July 10, 1951

Completed: July 27, 1951

Description:

NE 1/4 NE 1/4 NE 1/4 of
Sec. 18-28S-12W,
Stafford Co., KansasElev: 1902' R.B.
1900' D.F.

Formation	From	To	Remarks
Shale & Sand	0	130	
Red Bed	130	293	
Shale & Shells	293	675	Cemented with 150 sax cement
Sand & Shale	675	1220	
Shale	1220	1650	
Lime	1650	1820	
Sandy Lime	1820	1960	
Lime & Shale	1960	2085	
Shale	2085	2100	
Lime	2100	2265	
Shale	2265	2310	
Lime	2310	2355	
Lime & Shale Drake	2355	2400	
Shale & Lime	2400	2500	
Lime & Shale	2500	2920	
Shale	2920	3000	
Lime	3000	3475	
Lime & Shale	3475	3640	
Lime	3640	3864	
Lime & Shale	3864	3950	
Lime	3950	3980	
Shale & Sand	3980	4015	
Lime & Chert	4015	4059	
Lime	4059	4070	
Lime Cherty	4070	4106	
Lime	4106	4210	
	T.D.	4210	

TOPS:	Heebner	3435'	Mississippi	3959'
	Brown Lime	3574	Viola	4013
	Lansing	3596	Simpson	4107
			Arbuckle	4180

I certify that this is a true and correct copy of the Driller's Log of the above well to the best of my knowledge.

Subscribed and sworn to before me this 28th day of July, 1951.

RECEIVED
STATE CORPORATION DIVISION
JUL 30 1951 7-30-51
CONSERVATION DIVISION
Wichita, Kansas

Al Skalsky

Notary Public
Anna Beth Huffine

Notary Public
My commission expires April 6, 1955

PLUGGING
FILE SEC 18-28S-12W
BOOK PAGE 99 UNIT 35