


STATE OF KANSAS  
STATE CORPORATION COMMISSION

Give All Information Completely  
Make Required Affidavit  
Mail or Deliver Report to:  
Conservation Division  
State Corporation Commission  
800 Biting Building  
Wichita, Kansas

15-185-00164-0000

WELL PLUGGING RECORD

NORTH

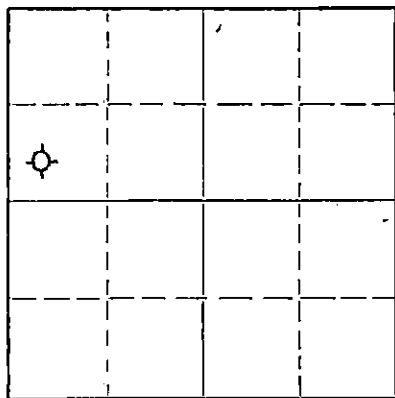

Locate well correctly on above  
Section Plat

Stafford County, Sec. 6 Twp. 25S Rge. (E) 12 (W)  
Location as "NE/CNW/SW" or footage from lines SW SW NW  
Lease Owner Rocket Drilling Company  
Lease Name Winchester Well No. 1  
Office Address 352 North Broadway, Wichita 2, Kansas  
Character of Well (completed as Oil, Gas or Dry Hole) Dry Hole  
Date well completed March 26, 1953  
Application for plugging filed March 26, (Oral) 1953  
Application for plugging approved March 27, 1953  
Plugging commenced March 26, 1953  
Plugging completed March 26, 1953  
Reason for abandonment of well or producing formation ---

If a producing well is abandoned, date of last production --- 19  
Was permission obtained from the Conservation Division or its agents before plugging was commenced? Yes

Name of Conservation Agent who supervised plugging of this well M. A. Rives, Box 148, Pratt, Kansas  
Producing formation Depth to top Bottom Total Depth of Well 4230 Feet  
Show depth and thickness of all water, oil and gas formations.

OIL, GAS OR WATER RECORDS

CASING RECORD

FORMATION	CONTENT	FROM	TO	SIZE	PUT IN	PULLED OUT
				8-5/8	193'	None

Describe in detail the manner in which the well was plugged, indicating where the mud fluid was placed and the method or methods used in introducing it into the hole. If cement or other plugs were used, state the character of same and depth placed, from feet to feet for each plug set.

Filled hole with mud to 193'. Set plug and cemented with 20 sacks. Filled hole with mud to 35'. Set plug and cemented with 10 sacks.

(If additional description is necessary, use BACK of this sheet)

Name of Plugging Contractor Rocket Drilling Company  
Address 352 North Broadway, Wichita 2, Kansas

STATE OF Kansas, COUNTY OF Sedgwick, ss.  
B. W. Burks (employee of owner) of the above-described well, being first duly sworn on oath, says: That I have knowledge of the facts, statements and matters herein contained and the log of the above-described well as filed and that the same are true and correct. So help me God.

(Signature) [Signature]  
352 North Broadway, Wichita 2, Kansas  
(Address)

SUBSCRIBED AND SWORN TO before me this 30th day of March, 1953

My commission expires 12-3-55

24-2675-S

2-52-20M

RECEIVED  
STATE CORPORATION COMMISSION

Notary Public.

PLUGGING  
FILE SEC. 6 T 25 R 12  
BOOK PAGE 87 LINE 34

MAR 31 1953 3-31-53

CONSERVATION DIVISION  
Wichita, Kansas

15-185-00164-0000

ROCKET DRILLING COMPANY  
352 North Broadway  
Wichita 2, Kansas

Rocket Drilling Company, Etal  
352 North Broadway  
Wichita 2, Kansas

#1 Winchester  
SW SW NW; 6-25-12W  
Stafford County, Kansas

Elevation: 1915 R.B.  
Spudded: March 10, 1953  
Rotary Completed: March 26, 1953  
Cable Tools Completed: None  
Acid Treatment: None  
Initial Production: Dry & Abandoned  
Contractor: Rocket Drilling Company

CASING RECORD

193' 8-5/8" O. D. 24# Seamless Casing Cemented With Bulk Cement.  
5-1/2" None.

DRILLERS LOG

Sand	0 to 145	Lime	2210 to 2350
Shale	707	Lime & Shale	2695
Anhydrite	738	Shale & Lime	2815
Shale	750	Lime	3420
Shale, Shells & Salt	1185	Shale & Shells	3510
Salt, Shale & Shells	1750	Lime & Shale	3602
Lime	1948	Lime	3957
Sand	1955	Lime & Shaly Congl.	3973
Lime	1990	Shale	4023
Sand	1995	Chert	4173
Lime	2202	Shale & Sand	4205
Sand	2210	Arbuckle	4230 TD

STATE OF KANSAS)  
SEDGWICK COUNTY) SS:

I hereby certify that to the best of my knowledge and belief,  
the foregoing log is true and correct.

ROCKET DRILLING COMPANY

By [Signature]

Subscribed and sworn to before me, a Notary Public, in and for  
the State and County aforesaid this 30th day of March, 1953.

My Commission Expires: 12-3-55 MAR 31 1953

THE CORPORATION COMMISSION

3-31-53

CONSERVATION DIVISION  
Wichita, Kansas

Notary Public

**PLUGGING**

FILE SEC 6 T 25 R 123  
BOOK PAGE 87 LINE 34