


STATE OF KANSAS
STATE CORPORATION COMMISSION

WELL PLUGGING RECORD

Give All Information Completely
Make Required Affidavit
Mail or Deliver Report to
Conservation Division
State Corporation Comm.
245 North Water
Wichita, KS 67202

Stafford County, Sec. 6 Twp. 25S Rge. 12 E/W
Location as "NE/CNW $\frac{1}{4}$ SW $\frac{1}{4}$ " or footage from lines
SE SE SE

Lease Owner The Tipton Corporation
Lease Name Garey Well No. 1
Office Address P.O. Box 157, Hays, Kansas 67601
Character of Well (Completed as Oil, Gas or Dry Hole)
Dry Hole

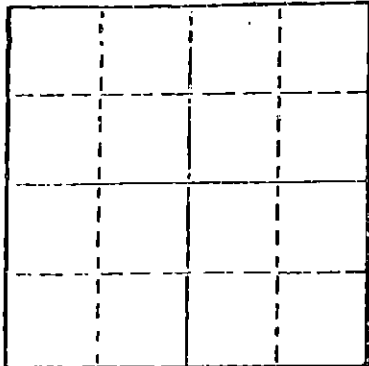

Locate well correctly on above
Section Plot

Date Well completed March 5, 1981
Application for plugging filed March 5, 1981
Application for plugging approved March 5, 1981
Plugging commenced March 5, 1981
Plugging completed March 5, 1981
Reason for abandonment of well or producing formation
Dry Hole

If a producing well is abandoned, date of last production
19

Was permission obtained from the Conservation Division or
its agents before plugging was commenced? Yes

Name of Conservation Agent who supervised plugging of this well Morris Lesslie
Producing formation Depth to top Bottom Total Depth of Well 4215'
Show depth and thickness of all water, oil and gas formations.

OIL, GAS OR WATER RECORDS

CASING RECORD

FORMATION	CONTENT	FROM	TO	SIZE	PUT IN	PULLED OUT
				8 5/8"	270'	


Describe in detail the manner in which the well was plugged, indicating where the mud fluid
was placed and the method or methods used in introducing it into the hold. If cement or other
plugs were used, state the character of same and depth placed, from feet to
feet for each plug set.

1st Plug @ 520' w/40 Sk.
2nd Plug @ 270' w/40 Sk.
3rd Plug @ 40' w/10 Sk.
10 Sk. in rat hole

3-13-81

(If additional description is necessary, use BACK of this sheet)

Name of Plugging Contractor RoCo Drilling, Inc.

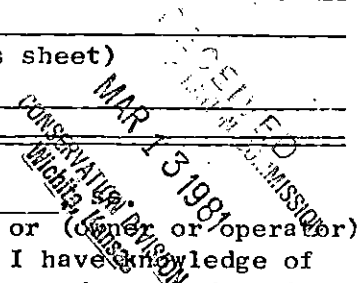

STATE OF KANSAS COUNTY OF BARTON
Richard L. Miller (employee of owner) or (owner or operator)
of the above-described well, being first duly sworn on oath, says: That I have knowledge of
the facts, statements, and matters herein contained and the log of the above-described well
as filed and that the same are true and correct. So help me God.

(Signature) Richard L. Miller
1819 11th St. Great Bend, Ks 67530
(Address) March, 1981



Carmen R. Cook Notary Public.

My commission expires Dec. 12, 1982

ROCO DRILLING, INC.

15-185-21174-0000

GREAT BEND, KANSAS 67530

P. O. BOX 11
1819 ELEVENTH STREET
TELEPHONE (316) 792-1383

DRILLERS WELL LOG

Garey #1
SE SE SE, Section 6-25S-12W
Stafford County, Kansas

Operator: The Tipton Corporation
P.O. Box 157
Hays, Kansas 67601

Date Commenced: February 24, 1981
Date Completed: March 5, 1981

Elevation: 1904' K.B.
Total Depth 4215'
Loggers T.D. 4215'
D & A

Casing: 8 5/8" @ 270' w/200 Sks.

<u>DEPTH</u>		<u>FORMATION</u>
<u>FROM</u>	<u>TO</u>	
0	722	Surface Soil, Sand & Shale
722	748	ANHYDRITE
748	1240	Shale & Shells
1240	1850	Shale, Shells & Gyp
1850	3413	Lime & Shale
3413	3421	HEEBNER SHALE
3421	3598	Lime, Shale & Sand
3598	3877	Lime & Shale
3877	4019	Lime, Chert, Sand & Shale
4019	4140	Chert & Lime
4140	4203	Shale & Sand
4203	4215	ARBUCKLE DOLOMITE
	4215	Rotary Total Depth

I, Richard L. Miller, certify this is a correct copy of the Driller's Log from the well drilled at the above location, to the best of my knowledge and belief.

Signed Richard L. Miller
Richard L. Miller

3-13-81
RECEIVED
TIPTON CORPORATION CO. MISSION
MAR 13 1981
CONSERVATION DIVISION
Topeka, Kansas