

WELL PLUGGING RECORD

Give All Information Completely
Make Required Affidavit
Mail or Deliver Report to:
Conservation Division
State Corporation Commission
212 No. Market
Wichita, Kansas

Kearny County, Sec 20 Twp 25S Rge. (E) 36 (W)

Location as "NE/CNW/SW" or footage from lines 100 ft East of NW NW

Lease Owner Petroleum Exploration, Inc.

Lease Name Lee Well No. 1A-20

Office Address 180 Cook St., Suite 211, Denver, Colorado 80202

Character of Well (completed as Oil, Gas or Dry Hole) Dry Hole

Date well completed January 25 19 72

Application for plugging filed January 25 19 72

Application for plugging approved January 25 19 72


Plugging commenced January 25 19 72

Plugging completed January 25 19 72

Reason for abandonment of well or producing formation Dry Hole

If a producing well is abandoned, date of last production None 19

Was permission obtained from the Conservation Division or its agents before plugging was commenced? Yes

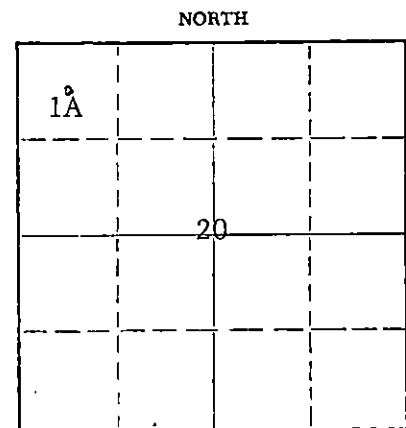

Locate well correctly on above Section Plat

Name of Conservation Agent who supervised plugging of this well Ed Eves

Producing formation None Depth to top Bottom Total Depth of Well 5658 Feet

Show depth and thickness of all water, oil and gas formations.

OIL, GAS OR WATER RECORDS

CASING RECORD

FORMATION	CONTENT	FROM	TO	SIZE	PUT IN	PULLED OUT
Lower KC	Water	4049	4082	8-5/8	1813	None

Describe in detail the manner in which the well was plugged, indicating where the mud fluid was placed and the method or methods used in introducing it into the hole. If cement or other plugs were used, state the character of same and depth placed, from feet to feet for each plug set.

Placed 100 sx (HOWCO) 50-50 pozmix w/3% gel @ 2650 feet, placed 45 visc drilling mud to 1000 feet. Placed 35 sx 50-50 pozmix w/3% gel @ 1000 ft, 45 visc mud to 45 ft. Placed 15 sx 50-50 pozmix w/3% gel @ 45 feet. Put 1 sack in rathole and one sack in mousehole. Job completed 6:45 p.m. January 25, 1972.

RECEIVED
STATE CORPORATION COMMISSION
FEB 8 1972
CONSERVATION DIVISION
WICHITA, KANSAS

(If additional description is necessary, use BACK of this sheet)

Name of Plugging Contractor Sterling Drilling Company

Address P. O. Box 129, Sterling, Kansas

STATE OF Oklahoma, COUNTY OF Tulsa, ss.

R. N. Knoblock of Stiles-Godsey Engrg., Inc. (employee of owner) or (owner or operator) of the above-described well, being first duly sworn on oath, says: That I have knowledge of the facts, statements, and matters herein contained and the log of the above-described well as filed and that the same are true and correct. So help me God.

(Signature) R. N. Knoblock

P. O. Box 4449, Tulsa, Oklahoma 74104

(Address)

SUBSCRIBED AND SWORN to before me this 28 day of January, 19 72

My commission expires 10-31-72

Walter H. Dowell
Notary Public.

STERLING DRILLING COMPANY
P. O. Box 129
Sterling, Kansas 67579

WELL LOG ----- LEE 1A-20
Located: NW/4NW, Section 20-25S-36W, Kearney County, Kansas

OWNER: Stiles-Godsey Engineering, Inc.
ROTARY DRILLING CONTRACTOR: Sterling Drilling Company

COMMENCED: January 6, 1972
COMPLETED: January 24, 1972

TOTAL DEPTH: 5658'

<u>LOG</u>	
0 - 730	Sand and Shale
730 - 895	Sand Red Bed
895 - 1570	Sand and Shale
1570 - 1655	Sand and Shale - Lime
1655 - 1812	Sand and Shale
1812 - 4862	Lime and Shale
4862 - 5279	Lime
5279 - 5355	Lime and Shale
5355 - 5658	Lime

CASING RECORD

Ran 1820', 57 joints, 8 5/8" 24# K-55 new casing, set at 1813' K.B., cemented with 600 sacks Halliburton light with 1/4# Flo-seal per sack and 2% cc, followed with 200 sacks common, salt saturated, with 3% cc. Plug down at 10:15 PM, 1-9-72.

Plugged.

RECEIVED
STATE CORPORATION COMMISSION
FEB 8 1972
CONSERVATION DIVISION
Wichita, Kansas

