


STATE OF KANSAS  
STATE CORPORATION COMMISSION

WELL PLUGGING RECORD

Give All Information Completely  
Make Required Affidavit  
Mail or Deliver Report to:  
Conservation Division  
State Corporation Commission  
800 Bittling Building  
Wichita, Kansas

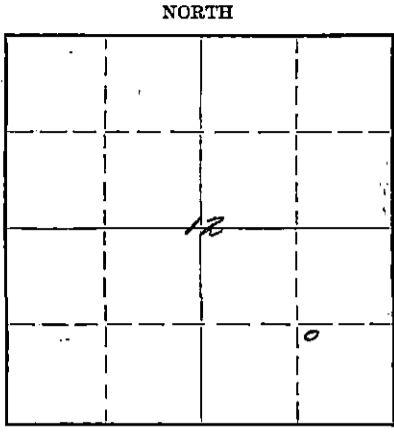

Hamilton County. Sec. 12 Twp. 25 Rge. (E) 39 (W)  
Location as "NE/CNW 1/4 SW 1/4" or footage from lines Spring Cr., S.E. 1/4  
Lease Owner Albert A. I. Hamilton  
Lease Name M. S. Donald Well No. 1  
Office Address 6929 2nd Ave. Kansas, Wis.  
Character of Well (completed as Oil, Gas or Dry Hole) Dry Hole  
Date well completed July 26 1954  
Application for plugging filed July 26 1954  
Application for plugging approved July 26 1954  
Plugging commenced July 30 1954  
Plugging completed July 30 1954  
Reason for abandonment of well or producing formation non productive

Locate well correctly on above Section Plat

Name of Conservation Agent who supervised plugging of this well G. H. Jones  
Producing formation Horton Pay Depth to top 2296 Bottom 2449 Total Depth of Well 2449 Feet  
Show depth and thickness of all water, oil and gas formations.

OIL, GAS OR WATER RECORDS

CASING RECORD

Formation	Content	From	To	Size	Put In	Pulled Out
	<u>Water</u>	<u>165</u>	<u>194</u>	<u>10 3/4</u>	<u>245</u>	<u>none</u>
				<u>7"</u>	<u>2296</u>	<u>700'</u>

Describe in detail the manner in which the well was plugged, indicating where the mud fluid was placed and the method or methods used in introducing it into the hole. If cement or other plugs were used, state the character of same and depth placed, from \_\_\_\_\_ feet to \_\_\_\_\_ feet for each plug set.

A Halliburton plug was driven to the bottom of the 10 3/4" surface pipe of which there was 245 feet. Then 5 sacks of Cement were mixed and dumped on top of the plug with cable tools. Another Halliburton plug was then set 35 feet below the surface with 5 sacks of Cement mixed and dumped on top. The 10 3/4" was then cut off 5 feet below the surface and a cap was welded on it.

(If additional description is necessary, use BACK of this sheet)

Name of Plugging Contractor R. N. Burris  
Address 509 Eugene, Garden City, Kansas

STATE OF Kansas, COUNTY OF Henry, SS. W. S. Jones (employee of owner) or (owner or operator) of the above-described well, being first duly sworn on oath, says: That I have knowledge of the facts, statements, and matters herein contained and the log of the above-described well as filed and that the same are true and correct. So help me God.

(Signature) W. S. Jones  
209 N 5 St Garden City, Kans. (Address)

SUBSCRIBED AND SWORN to before me this 31st day of July 1954  
Commission Expires Oct. 15, 1957  
Notary Public. J. W. Wells

My commission expires \_\_\_\_\_

PLUGGING  
FILE SEC 12 T 25 R 39W  
BOOK PAGE 53 LINE 7

RECEIVED  
STATE CORPORATION COMMISSION  
AUG 2 - 1954  
CONSERVATION DIVISION  
Wichita, Kansas

STATE <i>Mass</i>		COMPANY <i>A. Tharabrough</i>	
COUNTY <i>Hamilton</i>		FARM	WELL NO. <i>1</i>
BLOCK		SURVEY <i>MS Donald</i>	
SEC. <i>12</i>			
T. <i>25</i>	R. <i>39</i>	TOTAL DEPTH <i>2250</i>	
CONTRACTOR <i>BURRIS</i>		COMMENCED	
COMPLETED		REMARKS	
ALTIMETER <i>3179</i>		PRODUCTION <i>0.5 A</i>	

CASING RECORD

	10" $\frac{1}{2}$ <i>245'</i>	
	8"	
20"	6"	
15"	5"	
12"		
SHOT	QUARTS	BETWEEN

FORM 186-B For sale by Rees-Martin Co., Tulsa

0	
10	
20	
30	
40	
50	
60	
70	
80	
90	
100	
110	
120	
130	
140	
150	
160	
170	
180	
190	
200	
210	
220	
230	
240	
250	
260	
270	
280	
290	
300	
310	
320	
330	
340	
350	
360	
370	
380	
390	
400	
410	
420	
430	
440	
450	
460	
470	
480	
490	
500	
510	
520	
530	
540	
550	
560	
570	
580	
590	
600	
610	
620	
630	
640	
650	
660	
670	
680	
690	
700	
710	
720	
730	
740	
750	
760	
770	
780	
790	
800	
810	
820	
830	
840	
850	
860	
870	
880	
890	
900	
910	
920	
930	
940	
950	
960	
970	
980	
990	
1000	
1010	
1020	
1030	
1040	
1050	
1060	
1070	
1080	
1090	
1100	
1110	
1120	
1130	
1140	
1150	
1160	
1170	
1180	
1190	
1200	
1210	
1220	
1230	
1240	
1250	
1260	
1270	
1280	
1290	
1300	
1310	
1320	
1330	
1340	
1350	
1360	
1370	
1380	
1390	
1400	
1410	
1420	
1430	
1440	
1450	
1460	
1470	
1480	
1490	
1500	
1510	
1520	
1530	
1540	
1550	
1560	
1570	
1580	
1590	
1600	
1610	
1620	
1630	
1640	
1650	
1660	
1670	
1680	
1690	
1700	
1710	
1720	
1730	
1740	
1750	
1760	
1770	
1780	
1790	
1800	
1810	
1820	
1830	
1840	
1850	
1860	
1870	
1880	
1890	
1900	
1910	
1920	
1930	
1940	
1950	
1960	
1970	
1980	
1990	
2000	
2010	
2020	
2030	
2040	
2050	
2060	
2070	
2080	
2090	
2100	
2110	
2120	
2130	
2140	
2150	
2160	
2170	
2180	
2190	
2200	
2210	
2220	
2230	
2240	
2250	

*Hollenberg*  
lt gray to buff fine dense  
dolomite - slightly sandy

*Gray & red shale - dolomite  
in part.*

*Herrington*  
lt gray sandy shaly finely  
sh dolomite

*Gray & red shale slightly  
dolomitic.*

*Lowville*  
reddish gray shaly  
finely sandy dolomite

*Gray & Red shale.*

*St. Riley*  
reddish gray very sandy  
& very shaly dolomite

PLUGGING  
FILE NO. 2185 R 390  
BOOK PAGE 52 LINE 7