

STATE OF KANSAS
STATE CORPORATION COMMISSION


Give All Information Completely
Make Required Affidavit
Mail or Deliver Report to:
Conservation Division
State Corporation Commission
211 No. Broadway
Wichita, Kansas

WELL PLUGGING RECORD

Hamilton County, Sec. 5 Twp. 25S Rge. 40W (E) (W)

Location as "NE/CNW/SW" or footage from lines 1980' FS & E Lines
Lease Owner Phillips Petroleum Company
Lease Name Herndon "K" Well No. 1
Office Address Box 358, Phillips, Texas
Character of Well (completed as Oil, Gas or Dry Hole) Dry Hole
Date well completed September 26 19 65
Application for plugging filed September 26 19 65
Application for plugging approved September 26 19 65
Plugging commenced September 27 19 65
Plugging completed September 27 19 65
Reason for abandonment of well or producing formation Dry Hole

NORTH

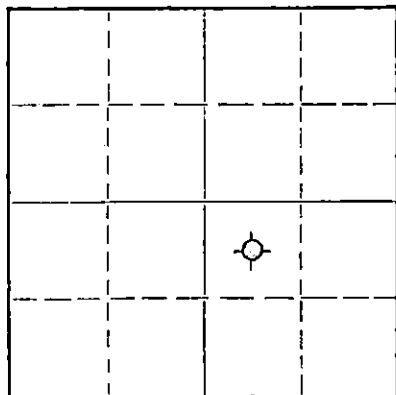

Locate well correctly on above
Section Plat

If a producing well is abandoned, date of last production No Production 19
Was permission obtained from the Conservation Division or its agents before plugging was commenced? Yes

Name of Conservation Agent who supervised plugging of this well Hugh E. Scott
Producing formation None Depth to top - Bottom - Total Depth of Well 2543 Feet
Show depth and thickness of all water, oil and gas formations.

OIL, GAS OR WATER RECORDS

CASING RECORD

FORMATION	CONTENT	FROM	TO	SIZE	PUT IN	PULLED OUT
Surf. Clay, Sand	Water	0	400	8 5/8" OD	507'	3'
No Gas or Oil Producing Formations				2 7/8" OD	2029'	90'
				2 1/16" OD	2019'	521'

Describe in detail the manner in which the well was plugged, indicating where the mud fluid was placed and the method or methods used in introducing it into the hole. If cement or other plugs were used, state the character of same and depth placed, from feet to feet for each plug set.

PBTD - 2 7/8" OD Casing 1962' - 2 1/16" Casing 1987'. Cemented perforations 1713' to 1696' with 15 sacks regular cement. Tested with 3000# psi and holding. Top of cement at 1500'. Backed off and recovered 90' of 2 7/8" OD Casing. Backed off 2 1/16" Casing at 521'. Mudded hole and spotted 35 sack regular cement plug from 525' to 425'. Pulled up 2 1/16" Casing to 50' and spotted 15 sack regular cement plug from 50' to surface. Pulled 2 1/16" Casing out of hole, cut 8 5/8" surface Casing 3' below surface and welded steel plate on top of surface Casing. Backfilled rat hole and cleaned and leveled location.

RECEIVED
STATE CORPORATION COMMISSION

OCT 4 1965

CONSERVATION DIVISION
Wichita, Kansas

(If additional description is necessary, use BACK of this sheet)

Name of Plugging Contractor Halliburton Company
Address Liberal, Kansas

STATE OF Texas, COUNTY OF Hutchinson, ss.
G. W. Cone (employee of owner) of the above-described well, being first duly sworn on oath, says: That I have knowledge of the facts, statements, and matters herein contained and the log of the above-described well as filed and that the same are true and correct. So help me God.

(Signature) G. W. Cone
Box 358, Phillips, Texas (Address)

SUBSCRIBED AND SWORN TO before me this 30th day of September, 19 65

My commission expires June 1, 1967
Maxine Jones
Notary Public.



LEASE: HERNDON "K" NO. 1
OWNER: PHILLIPS PETROLEUM COMPANY
CONT: EARL F. WAKEFIELD
COMM: 7-22-65
COMP: 8-2-65

LOCATION: 1980' FS&EL
SECTION 5-25S-40W
HAMILTON CO., KANSAS
CASING: 8 5/8" Set @ 506'
2 1/2" Set @ 2040'

Shale	509
Sand & Shale	688
Sand, Red Bed, Dolomite	1111
Red Shale & Salt	1669
Shale & Anhydrite	1753
Sand	1780
Coring	1867
Anhydrite	1988
Shale	2230
Red Shale, Anhydrite, Dolomite	2470
Coring	2543
R.T.D.	2543

2543 RECEIVED
STATE CORPORATION COMMISSION

STATE OF KANSAS)
) SS
COUNTY OF SEDGWICK)

OCT 4 1965

CONSERVATION DIVISION
Wichita, Kansas

I, FRED S. BARKER, DO HEREBY CERTIFY THAT THE ABOVE IS A TRUE AND CORRECT COPY OF THE DRILLER'S LOG ON HERNDON "K" WELL NO. 1, LOCATED 1980' FS&EL OF SECTION 5-25S-40W, HAMILTON COUNTY, KANSAS.

EARL F. WAKEFIELD

BY Fred S. Barker

SUBSCRIBED AND SWORN TO BEFORE ME THIS 20TH DAY OF AUGUST, 1965.

MY COMMISSION EXPIRES:
JANUARY 25, 1969

Wanda M. Riley
NOTARY PUBLIC