

STATE OF KANSAS
STATE CORPORATION COMMISSION


Give All Information Completely
Make Required Affidavit
Mail or Deliver Report to:
Conservation Division
State Corporation Commission
211 No. Broadway
Wichita, Kansas

WELL PLUGGING RECORD

Ford County, Sec. 2 Twp. 25 Rge. 21W (E) (W)

Location as "NE/CNW/SW" or footage from lines CNW SW
Lease Owner Artnell Company
Lease Name Stegman Well No. 1
Office Address 533 Petroleum Building, Wichita, Kansas
Character of Well (completed as Oil, Gas or Dry Hole) Dry Hole
Date well completed 1/1/60 19__
Application for plugging filed 1/1/60 19__
Application for plugging approved 1/1/60 19__
Plugging commenced 1/1/60 19__
Plugging completed 1/1/60 19__
Reason for abandonment of well or producing formation _____

NORTH

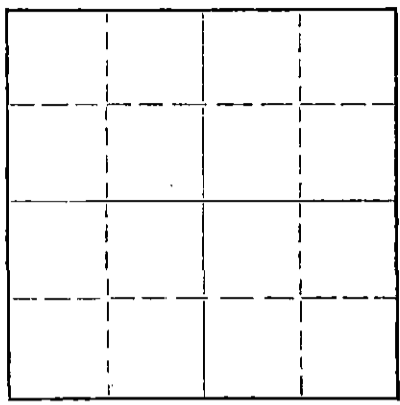

Locate well correctly on above
Section Plat

If a producing well is abandoned, date of last production _____ 19__
Was permission obtained from the Conservation Division or its agents before plugging was commenced? Yes

Name of Conservation Agent who supervised plugging of this well Frank Broadfoot, Stafford Co., St. John, Kans.
Producing formation _____ Depth to top _____ Bottom _____ Total Depth of Well 4753 Feet
Show depth and thickness of all water, oil and gas formations.

OIL, GAS OR WATER RECORDS

CASING RECORD

FORMATION	CONTENT	FROM	TO	SIZE	PUT IN	PULLED OUT
				8-5/8	355'	None

Describe in detail the manner in which the well was plugged, indicating where the mud fluid was placed and the method or methods used in introducing it into the hole. If cement or other plugs were used, state the character of same and depth placed, from 4753 feet to _____ feet for each plug set.

Filled hole from total depth, 4753, to 350' with heavy rotary mud; 1st plug set with 20sx cement & 1/3sk hulls; filled from 350' to 35' with mud; set 2nd plug with 10 sx cement & 1/3 sk hulls; filled to cellar with Heavy Rotary Mud.

RECEIVED
STATE CORPORATION COMMISSION

FEB 5 1960

CONSERVATION DIVISION

(If additional description is necessary, use BACK of this sheet)

Name of Plugging Contractor Strata Drilling, Inc.
Address 10th & O'Dell, Great Bend, Kansas

STATE OF Kansas, COUNTY OF Sedgwick, ss.
Donald R. Douglass (employee of owner) or (~~owner or operator~~) of the above-described well, being first duly sworn on oath, says: That I have knowledge of the facts, statements, and matters herein contained and the log of the above-described well as filed and that the same are true and correct. So help me God.

(Signature) Donald R. Douglass
533 Petroleum Building, Wichita, Kansas
(Address)

SUBSCRIBED AND SWORN TO before me this 3 day of February 19 60

My commission expires 2/24/60

Betty Baker
Betty Baker Notary Public.



DRILLERS LOG

#1 Stegman

CASING RECORD: 347' of used 8-5/8" surface casing	COMPANY: Artnell Company	DESCRIPTION: C/ NW SW Section 2-25-21W Ford County, Kansas
TOTAL DEPTH: 4753'	CONTRACTOR: Strata Drilling, Inc.	
	COMMENCED: December 18, 1959	
	COMPLETED: January 1, 1960	
	D. & A.	

<u>FORMATION</u>	<u>FROM</u>	<u>TO</u>	<u>REMARKS</u>
Clay & Shale	0	220	Ran 347' (17 Jts.) of used 8-5/8" surface casing; set and cemented @ 355' with 190 sacks of cement, 2% gel and 2% C. C.
Shale & Shells	220	355	
Shale	355	485	
Sand	485	650	
Shale & Sand Streaks	650	1185	
Shale & Lime	1650	1960	
Lime & Shale	1960	2665	
Lime	2665	2920	
Lime & Shale	2920	3855	
Lime	3855	3989	
Lime & Shale	3989	4045	DST #1 4708'-4725' Recovered 610' slightly oil cut salt water. IFP 115 lbs. FFP 305 lbs. BHP 1385 lbs. in 30 minutes.
Lime	4045	4645	
Lime & Shale	4645	4690	
Lime	4690	4725	
Chert & Lime	4725	4753	
Total Depth 4753'			

FEB 5 1960
GEOLOGICAL DIVISION
TOPEKA, KANSAS

D. & A. Plugged.

STATE OF KANSAS)
) ss:
COUNTY OF BARTON)

I certify that this is a true and correct copy of the above log to the best of my knowledge.

STRATA DRILLING, INC.

Jim B. McWilliams
Jim B. McWilliams, Secy-Treas.

Subscribed and sworn to before me this 5th day of January, 1960.

Elaine H. Taylor
Elaine H. Taylor, Notary Public

My Commission Expires:
December 14, 1961