


STATE OF KANSAS
STATE CORPORATION COMMISSION

WELL PLUGGING RECORD

Give All Information Completely
Make Required Affidavit
Mail or Deliver Report to:
Conservation Division
State Corporation Commission
211 No. Broadway
Wichita, Kansas

Edwards County, Sec. 23 Twp. 25S Rge. 16 ~~(E)XXX(W)~~

Location as "NE/CNW/SW" or footage from lines NE NE SW
Lease Owner D. R. Lauck Oil Company, Inc.
Lease Name Budde Well No. 1
Office Address 301 South Broadway Wichita 2 Kans
Character of Well (completed as Oil, Gas or Dry Hole) dry hole
Date well completed December 7 19 57
Application for plugging filed December 7 19 57
Application for plugging approved December 7 19 57
Plugging commenced December 7 19 57
Plugging completed December 7 19 57
Reason for abandonment of well or producing formation Dry hole

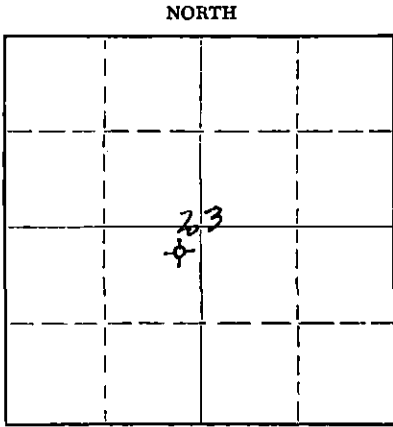

Locate well correctly on above
Section Plat

If a producing well is abandoned, date of last production -- 19 --
Was permission obtained from the Conservation Division or its agents before plugging was commenced? YES

Name of Conservation Agent who supervised plugging of this well N.A. Rives
Producing formation _____ Depth to top _____ Bottom _____ Total Depth of Well 4457 Feet
Show depth and thickness of all water, oil and gas formations.

OIL, GAS OR WATER RECORDS

CASING RECORD

FORMATION	CONTENT	FROM	TO	SIZE	PUT IN	PULLED OUT
		0	229'	8 5/8"	229'	none

Describe in detail the manner in which the well was plugged, indicating where the mud fluid was placed and the method or methods used in introducing it into the hole. If cement or other plugs were used, state the character of same and depth placed, from _____ feet to _____ feet for each plug set.

hole filled with mud	4457 - 225
plug	225 - 221
20 sacks cement & Part sack	
hulls	221 - 181
mud	181 - 35
plug	35 - 31
10 sacks cement & part sack hulls	31 - 6' bottom of cellar

(If additional description is necessary, use BACK of this sheet)

Name of Plugging Contractor Sun Cementing Company
Address Great Bend Kansas

STATE OF Kansas, COUNTY OF Sedgwick, ss.
John H. Knightley (employee of owner) or (owner/operator) of the above-described well, being first duly sworn on oath, says: That I have knowledge of the facts, statements, and matters herein contained and the log of the above-described well as filed and that the same are true and correct. So help me God.

(Signature) John H. Knightley
Wichita Kansas
(Address)

SUBSCRIBED AND SWORN to before me this 12 day of December, 19 57



RECEIVED
STATE CORPORATION COMMISSION

DEC 13 1957
CONSERVATION DIVISION
Wichita, Kansas

Elizabeth Gay Notary Public.
PLUGGING
FILE SEC 23 T 25 R 16
BOOK PAGE 67 LINE 36

D. R. Lauck Oil Company, Inc.

Budde #1

NE NE SW Sec.23-25S-16W
Edwards County Kansas

Commenced: November 24, 1957
Completed: December 7, 1957

Casing Record: 229' 8 5/8" cemented with 225 sacks

Elevation: GR 2056; DF 2058; KB 2060

Drillers Log

Tops

			Sample	Welex
sand & shale	70	Anhydrite (Driller)	1050+1010	
sand and shells	192	Heebner	3717-1657	3716-1656
shale & shells	229	Toronto	3736-1676	3736-1676
blue shale	295	Douglas	3752-1692	3753-1693
sand	315	Brown Lime	3858-1798	3858-1798
shale & sand streaks	370	Lansing	3871-1811	3874-1814
red bed	720	Base Kansas City		4146-2086
sand & shale-streaks	930	Conglomerate	4328-2268	4328-2268
sand	1050	sand	4342-2282	4342-2282
Anhydrite	1068	Mississippian	4347-2287	4348-2288
shale & shells (some salt)-	1675	Kinderhook shale	4361-2301	4364-2304
shale & shells	1935	Viola	4407-2347	4408-2348
lime & shale	2170	Total Depth	4457-2397	4457-2397
lime	2260			
lime & shale	2390	DST #1 4340-4348	(S) open 1 hr; weak	
lime - cherty & broken	2410		steady blow	
lime	2445		throughout;	
lime & shale	3360		Recov.30' slightyoil	
lime	3440		and gas cut mud;	
broken lime & shale	3510		BHP 85# in 20 min.	
lime	3752		F P's 0-0.	
lime & shale	3815			
shale	3858			
lime	4145		D & A	
lime, shale & sand	4185			
lime & shale	4300			
lime, shale, chert & sand	4343			
sand -conglomerate	4348			
chert & Miss.Lime	4370			
shale, lime & chert	4405			
shale & chert	4457			

R.T.D.

RECEIVED
STATE COMMISSION

DEC 13 1957

CONSERVATION DIVISION
Wichita, Kansas

PLUGGING
FILE SEC 23 T. 25 R. 16W
BOOK PAGE 67 LINE 36.