


STATE OF KANSAS
STATE CORPORATION COMMISSION

WELL PLUGGING RECORD

Give All Information Completely
Make Required Affidavit
Mail or Deliver Report to:
Conservation Division
State Corporation Commission
212 North Market, Insurance Bldg.
Wichita, Kansas

Edwards County. Sec. 22 Twp. 25 Rge. 16 (E) W.(W)
Location as "NE/CNW/SW" or footage from lines 1980' S. & 660' W. of NE Cor.
Lease Owner Cities Service Oil Company
Lease Name Budde Well No. 1
Office Address Box 144, Great Bend, Kansas
Character of Well (completed as Oil, Gas or Dry Hole) Dry Hole
Date well completed April 23 1960
Application for plugging filed April 23 1960
Application for plugging approved April 23 1960
Plugging commenced April 23 1960
Plugging completed April 23 1960
Reason for abandonment of well or producing formation Dry Hole

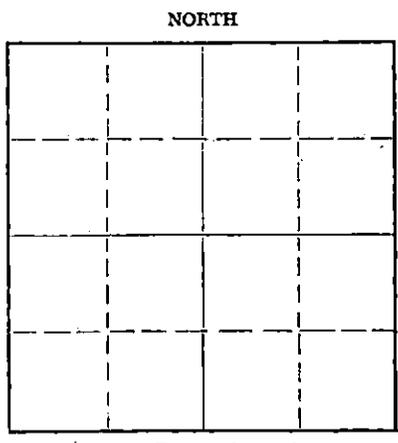

Locate well correctly on above Section Plat

If a producing well is abandoned, date of last production - 19-
Was permission obtained from the Conservation Division or its agents before plugging was commenced? Yes

Name of Conservation Agent who supervised plugging of this well Frank Broadfoot
Producing formation None Depth to top - Bottom - Total Depth of Well 4440 Feet
Show depth and thickness of all water, oil and gas formations.

OIL, GAS OR WATER RECORDS

CASING RECORD

FORMATION	CONTENT	FROM	TO	SIZE	PUT IN	PULLED OUT
				8-5/8"	349'	None

Describe in detail the manner in which the well was plugged, indicating where the mud fluid was placed and the method or methods used in introducing it into the hole. If cement or other plugs were used, state the character of same and depth placed, from _____ feet to _____ feet for each plug set.

4440-300', heavy mud.
300-240', wood plug, hulls and 30 sacks cement.
240- 40', mud.
40' to base of cellar, wood plug, hulls and 10 sacks cement.

RECEIVED
STATE CORPORATION COMMISSION
MAY 4 1960
CONSERVATION DIVISION
Wichita, Kansas

(If additional description is necessary, use BACK of this sheet)

Name of Plugging Contractor Barbour Drilling Company
Address Tulsa, Oklahoma

STATE OF Kansas, COUNTY OF Barton, ss.
John D. Forsyth (employee of owner) or (owner or operator) of the above-described well, being first duly sworn on oath, says: That I have knowledge of the facts, statements, and matters herein contained and the log of the above-described well as filed and that the same are true and correct. So help me God.

(Signature) John D. Forsyth
Box 144, Great Bend, Kansas
(Address)

SUBSCRIBED AND SWORN TO before me this 28th day of April, 19 60

W. D. Smith
Notary Public.

My commission expires March 12, 1963.

WELL RECORD

WILDCAT.....
 DISCOVERY.....
 POOL.....
 COMPANY Cities Service Oil Co. WELL # 1 FARM Budde
 LOCATION 1980' South and 660' West of NE Corner,
Section 22, Township 25, Range 16 W.
 ELEV. 2067 CO. Edwards STATE Kansas
 IP. Dry hole. P. and A. April 23, 1960.
 PERFS.....
 FRAC..... ACID None
 T.D. 4440' PBD..... GRAV/GOR.....
 DRLG. COMM. April 7, 1960 COMP. April 22, 1960 CONTRACTOR Barbour Drlg. Company

CASING RECORD:

8-5/8" at 349' with 250 sacks cement.

FORMATION RECORD:

clay and sand	0-100
sand	155
shale and shells	400
shale and red bed	1100
shale	1990
shale and lime	2145
lime	2365
lime and shale	2800
shale and lime	2970
shale	3115
shale and lime	3515
lime and shale	3610
lime	3725
lime and shale	3877
lime	4333
lime and shale	4355
lime	4361
shale and lime	4400
lime	4405
shale and cherty lime	4435
chert	4440 T.D.

Heebner	3708
Dodge	3727
Douglas	3752
Brown limestone	3849
Lansing	3859
Base Kansas City	4150
Cherokee shale	4302
Cherokee sand	4307
Cherty Conglomerate	4330
Kinderhook shale	4365
Viola	4415
Pen.	25'
T.D.	4440

D.S.T. 4302-23, open 1 hour, gas in 3 mins.,
 485 M.C.F. in 1 hr., rec. 50' gassy mud;
 B.H.P. 1240# in 30 minutes.
 D.S.T. 4348-61, open 1 hr., rec. 35' mud
 with few specks oil; I.B.H.P. 415# in
 30 mins., F.B.H.P. 70# in 30 mins.
 D.S.T. 4371-4405, open 1 hr., rec. 15' mud;
 B.H.P. 45# in 30 mins.

Slope Tests (Totco):

165'	- 0°
315'	- 1/4°
500'	- 1/2°
1000'	- 1/2°
1500'	- 3/4°
1940'	- 1°
2400'	- 1-3/4°
2650'	- 1°
3125'	- 1°
3615'	- 2°
3955'	- 2°
4300'	- 2-1/2°

RECEIVED
 STATE CORPORATION COMMISSION

MAY 4 1960
 CONSERVATION DIVISION
 Wichita, Kansas