

STATE OF KANSAS
STATE CORPORATION COMMISSION


WELL PLUGGING RECORD

Give All Information Completely
Make Required Affidavit
Mail or Deliver Report to:
Conservation Division
State Corporation Commission
211 No. Broadway
Wichita, Kansas

EDWARDS County. Sec. 28 Twp. 25S Rge. 16W (#) (W)

Location as "NE/CNW/SW" or footage from lines SE/4 NE/4
Lease Owner HUMBLE OIL REFINING CO.
Lease Name SADIE ENGLISH Well No. 1
Office Address BOX 949, GREAT BEND, KANSAS
Character of Well (completed as Oil, Gas or Dry Hole) DRY HOLE
Date well completed 8-1-62 19
Application for plugging filed 8-1-62 19
Application for plugging approved 19
Plugging commenced 8-1-62 19
Plugging completed 8-1-62 19
Reason for abandonment of well or producing formation DRY HOLE

NORTH

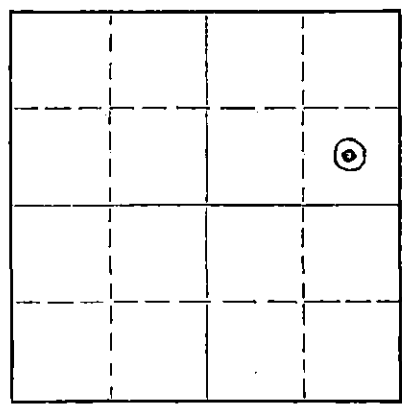

Locate well correctly on above
Section Plat

If a producing well is abandoned, date of last production 19
Was permission obtained from the Conservation Division or its agents before plugging was commenced? YES

Name of Conservation Agent who supervised plugging of this well W. L. LACKAMP
Producing formation Depth to top Bottom Total Depth of Well 4425 Feet
Show depth and thickness of all water, oil and gas formations.

OIL, GAS OR WATER RECORDS

CASING RECORD

FORMATION	CONTENT	FROM	TO	SIZE	PUT IN	PULLED OUT

Describe in detail the manner in which the well was plugged, indicating where the mud fluid was placed and the method or methods used in introducing it into the hole. If cement or other plugs were used, state the character of same and depth placed, from feet to feet for each plug set.
PLUGGED WITH 40 SACKS 50-60 POZMIK FROM 4425'-4280' MUD TO 393' 15 SACKS POZMIK FROM 393'-348' MUD TO 55' 20 SACKS POZMIK FROM 55' TO SURFACE. USED DUMP METHOD.

RECEIVED
STATE CORPORATION COMMISSION
AUG 6 1962
CONSERVATION DIVISION
Wichita, Kansas

(If additional description is necessary, use BACK of this sheet)
Name of Plugging Contractor HARMS DRILLING CO.
Address BOX 488, GREAT BEND, KANSAS

STATE OF KANSAS, COUNTY OF BARTON, ss.
J.D. SIMMONS (employee of owner) or (~~owner or operator~~) of the above-described well, being first duly sworn on oath, says: That I have knowledge of the facts, statements, and matters herein contained and the log of the above-described well as filed and that the same are true and correct. So help me God.

(Signature) J.D. Simmons
BOX 949, GREAT BEND, KANSAS
(Address)

SUBSCRIBED AND SWORN TO before me this 3rd day of August, 1962

My commission expires August 19, 1964
W. H. Kinsley Notary Public.

INVOICED
DATE 8/6/62
INV. NO. 5490-W

COMPANY: Humble Oil & Refining Co.
FARM: Sadie English #1
COMMENCED: July 20, 1962

Location County, Kansas
Completed: August 1,

Elevation: 2069 DF

0 - 170 sand
170 - 395 shale
395 - 490 shale-red bed
490 - 590 shale
590 - 1085 shale-red bed
1085 - 1963 anhydrite-shale-shells
1965 - 2695 shale-lime
2695 - 3777 lime-shale
3777 - 3890 shale
3890 - 4062 lime
4062 - 4353 lime-shale
4353 - 4400 lime-shale-sand
4400 - 4413 Conglomerate
4413 - 4425 Mississippi
4425 Total depth

Set 395' of 8 5/8" surface casing. Cemented with 250 sacks of posmix and 150 sacks of common cement with 2% calcium chloride.

Tops: Anhydrite - 1085
Douglas - 3777
Lansing-K.C. - 3890
Conglomerate - 4400
Mississippi - 4413

Drill Stem
Tests

#1 4385 - 4400 Open 1 hour. Shut in 20 minutes.
Recovered 8' oil specked slightly
gas cut mud.
ISP - 110# FSP - 86#
IFF - 0 FFP - 0

#2 4350 --4425 Open 30 minutes. Shut in 20 minutes.
Recovered 110' mud. 1 Hyd - 2350#
ISP - 693# IFF - 116
FFP - 104 F Hyd- 2343
FSP - 153#

Ran electric log.

Dry, plugged and abandoned.

A F F I D A V I T

STATE OF KANSAS)
) SS
COUNTY OF BARTON)

I, Allan Harms of the Harms Drilling Company being first duly sworn on oath state:
I have knowledge of the facts, statements and matters herein contained and the same
are true and correct.

Allan Harms
Allan Harms

Subscribed and sworn to before me this _____ day of _____, 1962.

Helen E. Gearhart
Helen E. Gearhart Notary Public

My commission expires:
January 22, 1966.