


STATE OF KANSAS
STATE CORPORATION COMMISSION

WELL PLUGGING RECORD

Give All Information Completely
Make Required Affidavit
Mail or Deliver Report to
Conservation Division
State Corporation Comm.
245 North Water
Wichita, KS 67202

Edwards County. Sec. 28 Twp. 25S Rge. 16W E/W
Location as "NE/CNW 1/4 SW 1/4" or footage from lines
N/2 N/2 NE

Lease Owner Oil Properties Co., Inc.
Lease Name Fouse "B" Well No. 1
Office Address Box 335, Andover, Kansas 67002
Character of Well (Completed as Oil, Gas or Dry Hole) Dry Hole

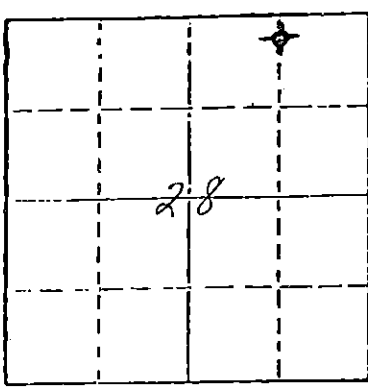

Locate well correctly on above
Section Plat

Date Well completed April 27, 1981
Application for plugging filed April 27, 1981
Application for plugging approved April 27, 1981
Plugging commenced April 27, 1981
Plugging completed April 27, 1981
Reason for abandonment of well or producing formation Dry Hole

If a producing well is abandoned, date of last production 19

Was permission obtained from the Conservation Division or its agents before plugging was commenced? Yes

Name of Conservation Agent who supervised plugging of this well Wm. T. Owen
Producing formation _____ Depth to top _____ Bottom _____ Total Depth of Well 4472'
Show depth and thickness of all water, oil and gas formations.

OIL, GAS OR WATER RECORDS

CASING RECORD

FORMATION	CONTENT	FROM	TO	SIZE	PUT IN	PULLED OUT
		0'	341'	8-5/8"	334'	None

Describe in detail the manner in which the well was plugged, indicating where the mud fluid was placed and the method or methods used in introducing it into the hold. If cement or other plugs were used, state the character of same and depth placed, from _____ feet to _____ feet for each plug set.

Plugged with 50 sacks cement at 600';
30 sacks cement at 340'; 10 sacks
cement at 40'; and 10 sacks cement in
rat hole.

(If additional description is necessary, use BACK of this sheet)

Name of Plugging Contractor Allied Cementing Co.

STATE OF KANSAS COUNTY OF SEDGWICK, ss.
John D. Knightley Agent (employee of owner) or (owner or operator)
of the above-described well, being first duly sworn on oath, says: That I have knowledge of the facts, statements, and matters herein contained and the log of the above-described well as filed and that the same are true and correct. So help me God.

(Signature) [Signature]
221 S. Broadway, Suite 400, Wichita, KS 67202
(Address)


SUBSCRIBED AND SWORN TO before me this 8th day of May, 1981

My commission expires March 12, 1983

Stella J. Lips
Notary Public.

RECEIVED
STATE CORPORATION COMMISSION

MAY 12 1981
CONSERVATION DIVISION
Wichita, Kansas

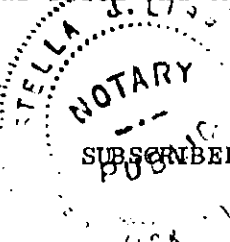

Oil Properties Co., Inc.
Box 335
Andover, Kansas 67002

-

Fouse "B" #1
N/2 N/2 NE Section 28-25S-16W
Edwards County, Kansas

Contractor: D. R. Lauck Oil Company, Inc.
221 S. Broadway, Suite 400
Wichita, Kansas 67202

Commenced: April 20, 1981
Completed: April 27, 1981

Drillers Log

Sand	140
Blue Shale	344
Red Bed	1077
Anhydrite	1090
Red Bed	1358
Shale & Shells	3735
Shale & Lime	4055
Lime & Shale	4375
Lime & Sand	4410
Lime & Shale	4472 RTD

RECEIVED
STATE CORPORATION COMMISSION

MAY 12 1981
CONSERVATION DIVISION
Wichita, Kansas