

STATE OF KANSAS
STATE CORPORATION COMMISSION


WELL PLUGGING RECORD

Give All Information Completely
Make Required Affidavit
Mail or Deliver Report to:
Conservation Division
State Corporation Commission
212 No. Market
Wichita, Kansas

Edwards County, Sec. 29 Twp. 25S Rge. 16W XEX (W)

Location as "NE/CNW%SW%" or footage from lines C NW NW
Lease Owner D. R. Lauck Oil Company, Inc.
Lease Name Parker "A" Well No. 1
Office Address 301 S. Broadway, Wichita, Kansas 67202
Character of Well (completed as Oil, Gas or Dry Hole) Dry Hole
Date well completed June 29, 19 74
Application for plugging filed June 29, 19 74
Application for plugging approved June 29, 19 74
Plugging commenced June 29, 19 74
Plugging completed June 29, 19 74
Reason for abandonment of well or producing formation Dry Hole

NORTH

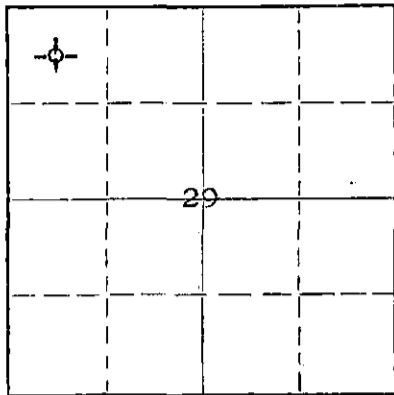

Locate well correctly on above Section Flat

If a producing well is abandoned, date of last production 19
Was permission obtained from the Conservation Division or its agents before plugging was commenced? Yes

Name of Conservation Agent who supervised plugging of this well G. R. Biberstein
Producing formation Depth to top Bottom Total Depth of Well 4460 Feet
Show depth and thickness of all water, oil and gas formations.

OIL, GAS OR WATER RECORDS

CASING RECORD

| FORMATION | CONTENT | FROM | TO | SIZE | PUT IN | PULLED OUT |
|-----------|---------|------|------|--------|--------|------------|
| | | 0' | 347' | 8-5/8" | 347' | None |
| | | | | | | |
| | | | | | | |
Describe in detail the manner in which the well was plugged, indicating where the mud fluid was placed and the method or methods used in introducing it into the hole. If cement or other plugs were used, state the character of same and depth placed, from feet to feet for each plug set.

4460'-300' - Hole filled with mud & hulls.
300'-296' - Plug
296'-40' - Cement, 35 sacks.
40'-36' - Plug
36'-6' - Cement, 15 sacks. (Bottom of cellar)
2 sacks cement in rat hole.

RECEIVED
STATE CORPORATION COMMISSION
JUL 9 1974
CONSERVATION DIVISION
Wichita, Kansas

(If additional description is necessary, use BACK of this sheet)
Name of Plugging Contractor Sun Cementing Co.
Address Great Bend, Kansas

STATE OF KANSAS, COUNTY OF SEDGWICK, ss.
John D. Knightley (employee of owner) or (owner or operator) of the above-described well, being first duly sworn on oath, says: That I have knowledge of the facts, statements, and matters herein contained and the log of the above-described well as filed and that the same are true and correct. So help me God.

(Signature) [Signature]
301 S. Broadway, Wichita, Kansas 67202
(Address)

SUBSCRIBED AND SWORN TO before me this 3rd day of July, 19 74.

[Signature] Notary Public.

My commission expires March 12, 1975

RECEIVED
STATE CORPORATION COMMISSION
JUL 9 1974
CONSERVATION DIVISION
Wichita, Kansas

D. R. Lauck Oil Company, Inc.

Parker "A" #1

C NW NW Sec. 29-25S-16W
Edwards County, Kansas

Commenced: June 19, 1974
Completed: June 29, 1974

Casing Record: 347' 8-5/8" Cemented with 225 sacks Cement,
2% Gel, 3% Calcium Chloride.

Elevation: GL 2078; DF 2081; KB 2083.

Drillers Log

Tops

| | | | |
|---------------------|------|------------------|-----------|
| Sand | 42 | | Sample |
| Sand & Shale | 175 | | |
| Shale, Shells, Sand | 349 | Anhydrite | 1080+1003 |
| Sand & Red Bed | 475 | Heebner | 3757-1674 |
| Shale | 940 | Toronto | 3773-1690 |
| Shale & Sand | 1080 | Douglas | 3797-1714 |
| Anhydrite | 1094 | Brown Lime | 3896-1813 |
| Shale & Shells | 2000 | Lansing | 3907-1824 |
| Lime & Shale | 2675 | Cherokee Shale | 4351-2268 |
| Shale & Lime | 2885 | Mississippian | 4393-2310 |
| Lime & Shale | 3230 | Kinderhook Shale | 4419-2336 |
| Shale & Lime | 3450 | Kinderhook Sand | 4444-2361 |
| Lime & Shale | 3815 | Total Depth | 4460-2377 |
| Shale & Lime | 3896 | | |
| Lime | 4355 | | |
| Lime & Chert | 4415 | | |
| Lime | 4460 | | |

DST #1, 4395-4415, open 30-30-45-30, anchor was plugged first 30 minutes. Weak steady blow first 30 minutes. Flushed tool. Good blow second 45 minutes. Recovered 150' mud. No ISIP, FSIP 389#. 2nd IFP 108#, 2nd FFP 108#.

DST #2, 4446-60, open 30-30-30-30, good blow 90 minutes, intermittent blow 30 minutes. Recovered 120' mud, 960' water. ISIP 1335#, FSIP 1247#. FP 111#-379# & 379#-469#.