

STATE OF KANSAS
STATE CORPORATION COMMISSION

WELL PLUGGING RECORD

Give All Information Completely
Make Required Affidavit
Mail or Deliver Report to
Conservation Division
State Corporation Comm.
245 North Water
Wichita, KS 67202

Edwards County. Sec. 6 Twp. 25S Rge. 16W E/W
Location as "NE/CNW $\frac{1}{4}$ SW $\frac{1}{4}$ " or footage from lines
440' N of C of South Line of Sec. 6-25S-16W

Lease Owner F. G. Holl, et al
Lease Name Bayless #1-6 Well No. 1

Office Address 6427 East Kellogg, Wichita, Kansas 67207
Character of Well (Completed as Oil, Gas or Dry Hole)

Dry Hole


Date Well completed August 18, 1978 19
Application for plugging filed August 17, 1978 19
Application for plugging approved August 17, 1978 19
Plugging commenced 2:00 AM, August 18, 1978 19
Plugging completed 4:15 AM, August 18, 1978 19
Reason for abandonment of well or producing formation

Dry Hole

If a producing well is abandoned, date of last production 19

Was permission obtained from the Conservation Division or its agents before plugging was commenced? Yes

Name of Conservation Agent who supervised plugging of this well Bill Owen
Producing formation Depth to top Bottom Total Depth of Well 4600'
Show depth and thickness of all water, oil and gas formations.

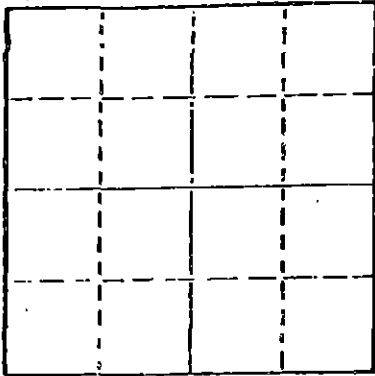

Locate well correctly on above Section Plot

OIL, GAS OR WATER RECORDS

CASING RECORD

FORMATION	CONTENT	FROM	TO	SIZE	PUT IN	PULLED OUT
				8 5/8"	296'	None

Describe in detail the manner in which the well was plugged, indicating where the mud fluid was placed and the method or methods used in introducing it into the hold. If cement or other plugs were used, state the character of same and depth placed, from feet to feet for each plug set.

RECEIVED
STATE CORPORATION COMMISSION

Filled hole with heavy mud.
Pumped thru open ended Drill Pipe
50 sacks of 50/50 Pozmix at 540' and
40 sacks at 300', solid bridge at 40'
with plug and 1/2 sack hulls and filled with
12 sacks to surface. 3 sacks in rathole.

AUG 21 1978

CONSERVATION DIVISION
Wichita, Kansas

(If additional description is necessary, use BACK of this sheet)

Name of Plugging Contractor Sterling Drilling Company
P. O. Box 129, Sterling, Kansas 67579

STATE OF KANSAS COUNTY OF RICE ss.
F. A. Wuellner

(employee of owner) or (owner or operator) of the above-described well, being first duly sworn on oath, says: That I have knowledge of the facts, statements, and matters herein contained and the log of the above-described well as filed and that the same are true and correct. So help me God. STERLING DRILLING COMPANY

(Signature) F. A. Wuellner
F. A. Wuellner, Secretary
P. O. Box 129, Sterling, Kansas 67579
(Address)

Subscribed and Sworn to before me this 19th day of August 1978

My commission expires



Charles M. Hall, Notary Public.

STERLING DRILLING COMPANY
P. O. Box 129
Sterling, Kansas 67579

WELL LOG ----- BAYLESS #1-6
Located: 440' N of C of South Line in Section 6-25S-16W,
Edwards County, Kansas

OWNER: F. G. Holl, et al
ROTARY DRILLING CONTRACTOR: Sterling Drilling Company

COMMENCED: August 11, 1978
COMPLETED: August 12, 1978

TOTAL DEPTH: 4600'

<u>LOG</u>	<u>CASING RECORD</u>
0 - 230 Sand, Clay and Gravel	Ran 7 joints used 28#, 8 5/8" casing, 283.66' set at 296' K.B. with 225 sacks 60/40 Pozmix with 3% cc. Plug down at 1:30 PM, 8-11-78, by Howco.
230 - 298 Shale	
298 - 414 Shale and Red Beds	
414 - 1122 Shale, Sand and Red Beds	
1122 - 1141 Anhydrite	
1141 - 1295 Shale	
1295 - 1840 Shale and Lime Stgs.	
1840 - 4295 Lime and Shale	
4295 - 4428 Chert, Lime and Shale, Sand and Shale	
4428 - 4600 Viola	Plugged.

RECORDED
STATE COMMISSION

AUG 21 1978

RECORDED
STATE COMMISSION