


STATE OF KANSAS
STATE CORPORATION COMMISSION

WELL PLUGGING RECORD

Give All Information Completely
Make Required Affidavit
Mail or Deliver Report to
Conservation Division
State Corporation Comm.
245 North Water
Wichita, KS 67202

Edwards County, Sec. 21 Twp. 25 Rge. 16 ~~EW~~
Location as "NE/CNW $\frac{1}{4}$ /SW $\frac{1}{4}$ " or footage from lines
C/SW/SW

Lease Owner White-Ellis Drilling Inc.
Lease Name Cudney Well No. 1
Office Address Box 448 Eldorado, KS 67042
Character of Well (Completed as Oil, Gas or Dry Hole)

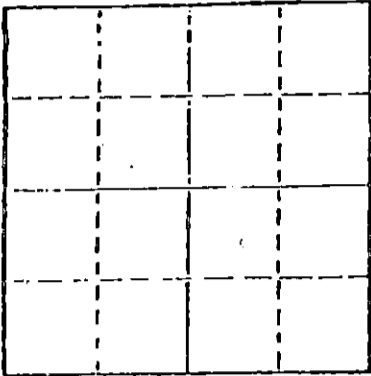

Locate well correctly on above
Section Plot

Oil
Date Well completed 19
Application for plugging filed 19
Application for plugging approved 19
Plugging commenced March 6 1979
Plugging completed March 19 1979
Reason for abandonment of well or producing formation
Depleted

If a producing well is abandoned, date of last production 19

Was permission obtained from the Conservation Division or
its agents before plugging was commenced? Yes

Name of Conservation Agent who supervised plugging of this well William Owen
Producing formation Depth to top Bottom Total Depth of Well 4458'
Show depth and thickness of all water, oil and gas formations.

OIL, GAS OR WATER RECORDS

CASING RECORD

FORMATION	CONTENT	FROM	TO	SIZE	PUT IN	PULLED OUT
				8 5/8"	362'	NONE
				4 1/2"	4457'	3288.60'

Describe in detail the manner in which the well was plugged, indicating where the mud fluid
was placed and the method or methods used in introducing it into the hold. If cement or other
plugs were used, state the character of same and depth placed, from feet to
feet for each plug set.

Dumped sand to 4350' with four (4) sacks cement
Shot pipe at 3800'
Pulled 115 joints of 4 1/2" casing
Squeezed well with five (5) sacks hulls, 25 sacks gel, 100 sacks 50/50 pozmix
with 6% added gel and 4% calcium chloride

RECEIVED
STATE CORPORATION COMMISSION

APR 16 1979

CONSERVATION DIVISION
Wichita, Kansas

(If additional description is necessary, use BACK of this sheet)

Name of Plugging Contractor Rockhold Engineering, Inc.

STATE OF KANSAS COUNTY OF BARTON, ss.
James W. Rockhold (employee of owner) or (owner or operator)
of the above-described well, being first duly sworn on oath, says: That I have knowledge of
the facts, statements, and matters herein contained and the log of the above-described well
as filed and that the same are true and correct. So help me God.

(Signature) James W. Rockhold
James W. Rockhold Box 698, Gt. Bend, KS
(Address) 67530

SUBSCRIBED AND SWORN TO before me this 13th day of April, 1979

STATE NOTARY PUBLIC
KANSAS
CATHY L. COLE
Barton County, Kansas
My Appt. Exp. 11/14/1980

Cathy L. Cole
Notary Public.

My commission expires

White & Ellis Drilling, Inc. - Cudney #1
C SW SW Sec. 21-25S-16W
Edwards County, Kansas

Contractor: D. R. Lauck Oil Company, Inc.
301 S. Broadway
Wichita, Kansas 67202

Commenced: September 26, 1976
Completed: October 7, 1976

Drillers Log

Sand	160
Shale & Sand	260
Sand	350
Shale	365
Shale & Sand	1060
Shale & Shells	1510
Shale & Lime	2000
Lime & Shale	3910
Lime	4458 RTD

RECEIVED
STATE CORPORATION COMMISSION
JAN - 2 1977
CONSERVATION DIVISION
Wichita, Kansas