


STATE OF KANSAS
STATE CORPORATION COMMISSION

WELL PLUGGING RECORD

Give All Information Completely
Make Required Affidavit
Mail or Deliver Report to:
Conservation Division
State Corporation Commission
800 Bittig Building
Wichita, Kansas

Edwards County, Sec. 21 Twp. 25 Rge. 16 (X) SW(W)
Location as "NE/CNW%SW%" or footage from lines SE NE
Lease Owner White Eagle Oil Company
Lease Name Apel Well No. 1
Office Address First Natl. Bk. Bldg., Tulsa, Oklahoma
Character of Well (completed as Oil, Gas or Dry Hole) Dry Hole
Date well completed 4-10 19 59
Application for plugging filed 4-13 19 59
Application for plugging approved 19
Plugging commenced 4-15 19 59
Plugging completed 4-22 19 59
Reason for abandonment of well or producing formation
Formation water, no oil or gas
If a producing well is abandoned, date of last production none 19
Was permission obtained from the Conservation Division or its agents before plugging was commenced? Yes

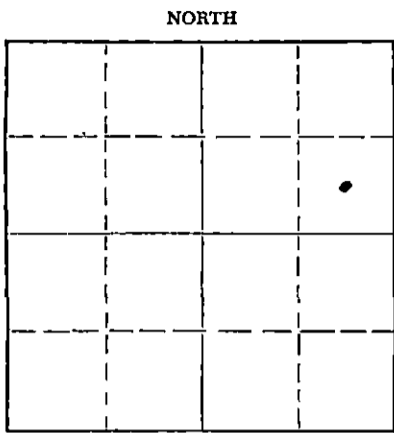

Locate well correctly on above Section Plat

Name of Conservation Agent who supervised plugging of this well Frank Broadfoot
Producing formation Depth to top Bottom Total Depth of Well 4507 Feet
Show depth and thickness of all water, oil and gas formations.

OIL, GAS OR WATER RECORDS

CASING RECORD

FORMATION	CONTENT	FROM	TO	SIZE	PUT IN	PULLED OUT
				8 5/8	287'	None
				5 1/2	4505'	3000'

Describe in detail the manner in which the well was plugged, indicating where the mud fluid was placed and the method or methods used in introducing it into the hole. If cement or other plugs were used, state the character of same and depth placed, from feet to feet for each plug set.

IW plug set at 4350'
Plug back with sand to 4320' dumped 5 sx cem,
Pulled 5 1/2 csg, filled hole with mud to 250' set 10' rock bridge
mixed and dumped 20 sx cem, filled hole with mud to 35' set rock
bridge mixed and put in 10 sx cem filled to base of cellar.

(If additional description is necessary, use BACK of this sheet)

Name of Plugging Contractor Ace Pipe pulling Co License No. 2
Address Great Bend, Kansas

STATE OF KANSAS, COUNTY OF FINNEY, ss.
T. E. MORT (employee of owner) or (~~owner or operator~~) of the above-described well, being first duly sworn on oath, says: That I have knowledge of the facts, statements, and matters herein contained and the log of the above-described well as filed and that the same are true and correct. So help me God.

(Signature) T. E. Mort
BOX # 255; GARDEN CITY, KANSAS
(Address)

SUBSCRIBED AND SWORN TO before me this 29th day of April, 19 59

Russell Wells
Notary Public.

My commission expires 11-29-60

PLUGGING
FILE SEC 21 Twp. 25 R. 16W
BOOK PAGE 89 LINE 26

RECEIVED
STATE CORPORATION COMMISSION

MAY 2 1959
CONSERVATION DIVISION
Wichita, Kansas

Copy

DRILLERS' LOG

Apel No. 1
Loc: C SE NE
Sec: 21-25S-16W
Edwards County, Kansas
Company: White Eagle Oil Company
Contractor: Honaker-Davis Drlg. Co.

Comm: 2-26-59
Comp: 3-11-59
Rotary Total Depth: 4505'
Casing: 8-5/8" at 287'
5-1/2" at 4504'

0	182	Sand	
182	288	Shale	8-5/8" casing cemented at
288	455	Blue Shale	287' with 300 sacks common
455	1080	Red Bed	cement, 2% jel and 2%
1080	1105	Anhydrite	calcium chloride.
1105	2080	Shale & Shells	
2080	2710	Lime & Shale	
2710	2975	Shale & Shells	
2975	3900	Lime & Shale	
3900	3975	Lime	
3975	4095	Lime & Shale	
4095	4165	Lime	
4165	4227	Lime & Shale	
4227	4330	Lime	
4330	4385	Lime & Chert	
4385	4434	Lime, Shale & Chert	
4434	4437	Chert	
4437	4505	Lime & Shale	5-1/2" casing cemented at
4505		Total Rotary Depth	4504' with 125 sacks

pssmix cement.

I certify that this is the true and correct copy of the
above log to the best of my knowledge.

H. C. Davis

H. C. Davis

Subscribed and sworn to before me this 12th day of
March, 1959.

Kenneth G. Fischer

Kenneth G. Fischer, Notary Public

My commission expires: 6-25-59

