


STATE OF KANSAS
STATE CORPORATION COMMISSION
CONSERVATION DIVISION
P. O. BOX 17027
WICHITA, KANSAS 67217

FORM CP-4

WELL PLUGGING RECORD

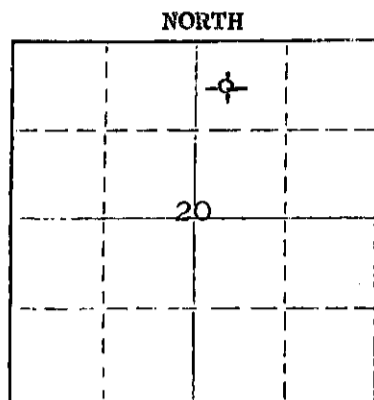

Locate well correctly on above Section Plot

Edwards County. Sec. 20 Twp. 25S Rge. 16W (X) (W)
Location as "NE/CNW&SW" or footage from lines W/2 NW NE
Lease Owner White & Ellis Drilling, Inc.
Lease Name Brown Well No. 1
Office Address Box 448, El Dorado, Kansas 67042
Character of Well (completed as Oil, Gas or Dry Hole) Dry Hole
Date well completed November 1, 1976
Application for plugging filed November 1, 1976
Application for plugging approved November 1, 1976
Plugging commenced November 1, 1976
Plugging completed November 1, 1976
Reason for abandonment of well or producing formation Dry Hole

If a producing well is abandoned, date of last production _____ 19____
Was permission obtained from the Conservation Division or its agents before plugging was commenced? Yes

Name of Conservation Agent who supervised plugging of this well _____
Producing formation _____ Depth to top _____ Bottom _____ Total Depth of Well 4434 Feet
Show depth and thickness of all water, oil and gas formations.

OIL, GAS OR WATER RECORDS				CASING RECORD		
FORMATION	CONTENT	FROM	TO	SIZE	PUT IN	PULLED OUT
		0'	367'	8-5/8"	360.70'	None

Describe in detail the manner in which the well was plugged, indicating where the mud fluid was placed and the method or methods used in introducing it into the hole. If cement or other plugs were used, state the character of same and depth placed, from _____ feet to _____ feet for each plug set.

Plug at 300' with 35 sacks cement,
plug at 40' with 15 sacks cement,
2 sacks cement in rat-hole.

RECEIVED
STATE CORPORATION COMMISSION
NOV 10 1976
CONSERVATION DIVISION
Wichita, Kansas

(If additional description is necessary, use BACK of this sheet)
Name of Plugging Contractor Halliburton Cementing Co.
Address El Dorado, Kansas

STATE OF KANSAS COUNTY OF SEDGWICK ss.

John D. Knightley, Agent (employee of owner) or (owner or operator) of the above-described well, being first duly sworn on oath, says: That I have knowledge of the facts, statements, and matters herein contained and the log of the above-described well as filed and that the same are true and correct. So help me God.

(Signature) [Signature]
301 S. Broadway, Wichita, Kansas
(Address)

SUBSCRIBED AND SWORN to before me this 9th day of November, 1976

My commission expires March 12, 1979
[Signature] Notary Public.

White & Ellis Drilling, Inc. - Brown #1
W/2 NW NE Sec. 20-25S-16W
Edwards County, Kansas

Contractor: D. R. Lauck Oil Company, Inc.
301 S. Broadway
Wichita, Kansas 67202

Commenced: October 22, 1976
Completed: November 1, 1976

Drillers Log

Sand	165
Shale & Sand Streaks	315
Sand	365
Shale	376
Shale & Sand	1190
Shale & Shells	1665
Shale & Lime	3130
Lime	3255
Lime & Shale	3575
Shale & Lime	3725
Lime & Shale	3950
Lime	4434 RTD

RECEIVED
STATE CORPORATION COMMISSION

NOV 10 1976

CONSERVATION DIVISION
Wichita, Kansas