

STATE OF KANSAS
STATE CORPORATION COMMISSION

WELL PLUGGING RECORD

Give All Information Completely
Make Required Affidavit
Mail or Deliver Report to
Conservation Division
State Corporation Comm.
245 North Water
Wichita, KS 67202

Edwards County. Sec. 20 Twp. 25S Rge. 16W & W
Location as "NE/CNW $\frac{1}{4}$ /SW $\frac{1}{4}$ " or footage from lines
C NW SW

Lease Owner D. R. Lauck Oil Company, Inc.
Lease Name Steward Well No. 2

Office Address 221 S. Broadway, Wichita, Kansas 67202

Character of Well (Completed as Oil, Gas or Dry Hole)
Dry Hole

Date Well completed October 19, 1978

Application for plugging filed October 19, 1978

Application for plugging approved October 19, 1978

Plugging commenced October 19, 1978

Plugging completed October 19, 1978

Reason for abandonment of well or producing formation
Dry Hole


If a producing well is abandoned, date of last production
19__

Was permission obtained from the Conservation Division or
its agents before plugging was commenced? Yes

Name of Conservation Agent who supervised plugging of this well Wm. T. Owen

Producing formation _____ Depth to top _____ Bottom _____ Total Depth of Well 4550'

Show depth and thickness of all water, oil and gas formations.

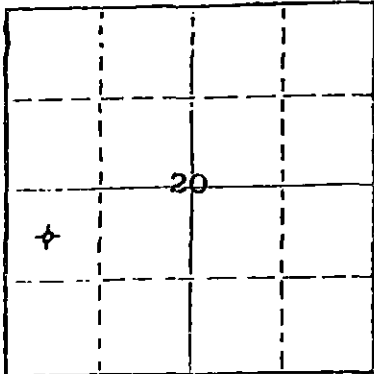

Locate well correctly on above
Section Plat

OIL, GAS OR WATER RECORDS

CASING RECORD

FORMATION	CONTENT	FROM	TO	SIZE	PUT IN	PULLED OUT
		0'	376'	8-5/8"	369.38'	None

Describe in detail the manner in which the well was plugged, indicating where the mud fluid was placed and the method or methods used in introducing it into the hold. If cement or other plugs were used, state the character of same and depth placed, from _____ feet to _____ feet for each plug set.

Plugged with 40 sacks common cement, at 360',
plug and 12 sacks cement at 40', 2 sacks cement in
rat hole.

(If additional description is necessary, use BACK of this sheet)

Name of Plugging Contractor Allied Cementing Co.

STATE OF KANSAS COUNTY OF SEDGWICK, ss.
John D. Knightley (employee of owner) or (owner or operator)
of the above-described well, being first duly sworn on oath, says: That I have knowledge of the facts, statements, and matters herein contained and the log of the above-described well as filed and that the same are true and correct. So help me God.

(Signature) [Signature]
221 S. Broadway, Wichita, Kansas
(Address)

SUBSCRIBED AND SWORN TO before me this 30th day of October, 1978

[Signature]
Notary Public.

My commission expires March 12, 1979

RECEIVED
STATE CORPORATION COMMISSION

OCT 31 1978

CONSERVATION DIVISION
Wichita, Kansas

D. R. Lauck Oil Company, Inc. - Steward #2
C NW SW Sec. 20-25S-16W
Edwards County, Kansas

Contractor: D. R. Lauck Oil Company, Inc.
221 S. Broadway, Suite 400
Wichita, Kansas 67202

Commenced: October 9, 1978
Completed: October 19, 1978

Drillers Log

Red Bed	1087
Anhydrite	1100
Shale	2120
Shale & Lime	3355
Lime	4090
Lime & Shale	4205
Lime	4550 RTD

RECEIVED
STATE CORPORATION COMMISSION

OCT 31 1978

CONSERVATION DIVISION
Wichita, Kansas