

WELL PLUGGING RECORD

Give All Information Completely  
Make Required Affidavit  
Mail or Deliver Report to:  
Conservation Division  
State Corporation Commission  
211 No. Broadway  
Wichita, Kansas

Edwards County, Sec. 18 Twp. 25S Rge. 16 (E) (W) X

Location as "NE/CNW/SW" or footage from lines Center of SW NE

Lease Owner Leben Drilling, Inc.

Lease Name Trousdale Well No. 1

Office Address P. O. Box 486 Great Bend, Kansas

Character of Well (completed as Oil, Gas or Dry Hole) \_\_\_\_\_

Date well completed \_\_\_\_\_ 19\_\_

Application for plugging filed 1-10-66 19\_\_

Application for plugging approved 1-12-66 19\_\_


Plugging commenced 3-19-66 19\_\_

Plugging completed 3-28-66 19\_\_

Reason for abandonment of well or producing formation \_\_\_\_\_

If a producing well is abandoned, date of last production \_\_\_\_\_ 19\_\_

Was permission obtained from the Conservation Division or its agents before plugging was commenced? Yes

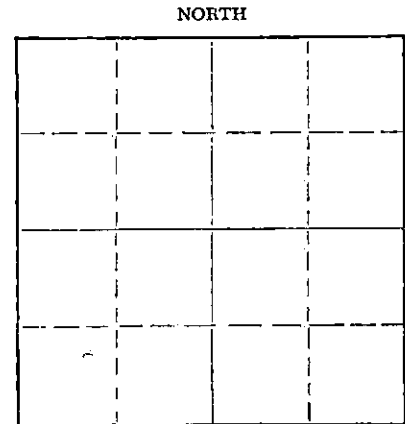

Locate well correctly on above Section Plat

Name of Conservation Agent who supervised plugging of this well Archie V. Elving

Producing formation \_\_\_\_\_ Depth to top \_\_\_\_\_ Bottom \_\_\_\_\_ Total Depth of Well 1426 Feet

Show depth and thickness of all water, oil and gas formations.

OIL, GAS OR WATER RECORDS

CASING RECORD

FORMATION	CONTENT	FROM	TO	SIZE	PUT IN	PULLED OUT
				8 5/8	298	None
				5 1/2	None	2249

Describe in detail the manner in which the well was plugged, indicating where the mud fluid was placed and the method or methods used in introducing it into the hole. If cement or other plugs were used, state the character of same and depth placed, from \_\_\_\_\_ feet to \_\_\_\_\_ feet for each plug set.

Moved in. Cleaned out cellar. Worked pipe. Sanded to 4300'. Dumped 5 sacks of cement.

Working pipe. Shot pipe at 2500' , 2300' and 2230'. Pulling pipe.

Pulling pipe. Plugging well. Bridged hole. Spudded out bridge. Bailing. Pushed plug to 285'. Build 10' rock bridge. Dumped 14 sacks of cement.

Bailed to 230'. Dumped 10 sacks of cement. Filled hole and rock bridge. Capped well with 10 sacks.

RECEIVED  
STATE CORPORATION COMMISSION

MAR 30 1966

(If additional description is necessary, use BACK of this sheet)

Name of Plugging Contractor Forbes Casing Pulling, Inc.

Address P. O. Box 221 Great Bend, Kansas

CONSERVATION DIVISION  
Wichita, Kansas

STATE OF Kansas COUNTY OF Barton, ss.

J. O. Forbes (employee of owner) or (owner or operator) of the above-described well, being first duly sworn on oath, says: That I have knowledge of the facts, statements, and matters herein contained and the log of the above-described well as filed and that the same are true and correct. So help me God.

(Signature) J. O. Forbes

P. O. Box 221 Great Bend, Kansas  
(Address)

SUBSCRIBED AND SWORN TO before me this 29 day of March, 19 66

My commission expires May 27, 1969

Notary Public.

DRILLER'S LOG

COMPANY: San Roque Oil & Exploration Co.  
 CONTRACTOR: LEBEN DRILLING, INC.  
 FARM: TROUSDALE #1  
 LOCATION: C SW NE Sec. 18-25S-16W  
 EDWARDS COUNTY, KANSAS  
 COMMENCED: 1-14-63  
 COMPLETED: 1-25-63

0	90	Sand
90	210	Sand & Shale
210	270	Sand
270	390	Shale
390	645	Redbed
645	1095	Redbed & Shale
1095	1115	Anhydrite
1115	2020	Shale & Shells
2020	2500	Lime
2500	2810	Lime & Shale
2810	2985	Lime
2985	3615	Lime & Shale
3615	3766	Lime
3766	3900	Lime & Shale
3900	4362	Lime
4362	4376	Lime & Shale
4376	4400	Mississippi Chert
4400	4450	Lime
	<u>4450</u>	<u>Rotary Total Depth - Set 5 1/2" Casing</u>

RECEIVED  
 STATE CORPORATION COMMISSION  
 APR 4 1966  
 CONSERVATION DIVISION  
 Wichita, Kansas

Set used 8 5/8" surface casing @ 291' Cemented with 300 sacks of Sunset by Sun Oilwell Cementing.

I, Byron Johnson, do hereby certify that the above and foregoing is a true and correct copy of the log of the Trousdale #1 located C SW NE of Section 18, Township 25 South, Range 16 West, Edwards County, Kansas as reflected by the files of Leben Drilling, Inc.

*Byron Johnson*  
 Byron Johnson

STATE OF KANSAS )  
 ) SS  
 COUNTY OF BARTON )

Subscribed and sworn to me, a Notary Public, in and for Barton County, Kansas, this 28th day of January, 1963.

*Ulanda Nichols*  
 Ulanda Nichols, Notary Public

My Commission Expires:  
 April 1, 1963