


STATE OF KANSAS
STATE CORPORATION COMMISSION

WELL PLUGGING RECORD

Give All Information Completely
Make Required Affidavit
Mail or Deliver Report to
Conservation Division
State Corporation Comm.
245 North Water
Wichita, KS 67202

Ford County, Sec. 25 Twp. 25S Rge. 21W E/W
Location as "NE/CNW $\frac{1}{4}$ SW $\frac{1}{4}$ " or footage from lines SE/NE

Lease Owner NFC Petroleum Corporation
Lease Name Herrmann Well No. #1
Office Address 3535 N. W. 58th Suite 920 OKC, OKLA.
Character of Well (Completed as Oil, Gas or Dry Hole)

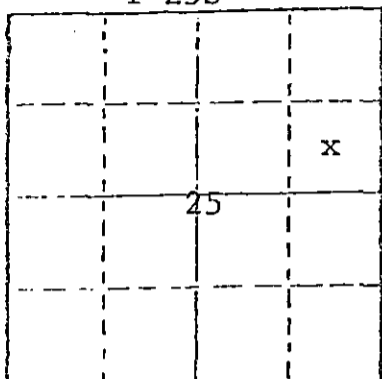

Locate well correctly on above Section Plot

Dry Hole
Date-Well-Completed 8/18/ 1977
Application for plugging filed 19
Application for plugging approved 19
Plugging commenced 8/18/ 1977
Plugging completed 8/18/ 1977
Reason for abandonment of well or producing formation

Dry Hole
If a producing well is abandoned, date of last production
N/A 19

Was permission obtained from the Conservation Division or its agents before plugging was commenced? Yes

Name of Conservation Agent who supervised plugging of this well Clarence Thomas Jr.
Producing formation None Depth to top Bottom Total Depth of Well
Show depth and thickness of all water, oil and gas formations.

OIL, GAS OR WATER RECORDS

CASING RECORD

FORMATION	CONTENT	FROM	TO	SIZE	PUT IN	PULLED OUT
Mississippi	Dry	4732'	4768'	8 5/8"	370	None

Describe in detail the manner in which the well was plugged, indicating where the mud fluid was placed and the method or methods used in introducing it into the hold. If cement or other plugs were used, state the character of same and depth placed, from feet to feet for each plug set. Hole filled with 9.1#/gal drilling mud. Spotted w/50 sacks cement plug from 1000' to 900'. Spotted 35 sacks cement plug from 400' to 300' and spotted w/15 sacks cement plug from 40' to 0'. Welded on steel cap and marked.

RECEIVED
STATE CORPORATION COMMISSION

AUG 24 1977

CONSERVATION DIVISION
Wichita, Kansas

Name of Plugging Contractor Halliburton, Pratt, Kansas
(If additional description is necessary, use BACK of this sheet)

STATE OF Oklahoma COUNTY OF Oklahoma, ss.
William Egg (employee of owner) or (owner or operator)
of the above-described well, being first duly sworn on oath, says: That I have knowledge of the facts, statements, and matters herein contained and the log of the above-described well as filed and that the same are true and correct. So help me God.

(Signature) William C. Egg
3535 NW 58th, Suite 920, OKC, OK 73112
(Address)

SUBSCRIBED AND SWORN TO before me this 23 day of August, 1977

Lisa DeWitt
Notary Public.

My commission expires 1-5-81

GABBERT-JONES, INC.
 WICHITA, KANSAS
 DRILLERS' WELL LOG

Herrman 1-25
 C-SE-NE Sec 25-25S-21W
 Ford County Kansas

Commenced: 8-8-77

Completed: 8-18-77

OPERATOR: NFC PETROLEUM CORP.

Depth From	to	Formation	Remarks
0	40	Top Soil-Clay	Ran 9 jts of 20# 8 5/8" csg
40	375	Sand-Shale	set @ 370' w/Texas Patteen
375	700	Shale-Sand	Shoe-Insert Floate @ 340 w/
700	815	Redbed-Shale	Centrilizer of 1st, 5th, 8th
815	1473	Redbed-Shells-Shale	Cemented w/300 sbs Common
1473	1911	Shale-Shells	2% Gel - 3% CC
1911	2400	Shale-Lime	PD @ 6:15 a.m. 8-9-77
2400	2565	Lime-Shale	
2565	2905	Shale-Lime	
2905	4145	Lime-Shale	
4145	4800	Lime	
4800	- TD		DRY & ABANDONED

STATE OF KANSAS)
) SS
 COUNTY OF SEDGWICK)

I, the undersigned, being duly sworn on oath, state that the above
 Drillers' Well Log is true and correct to the best of my knowledge and belief and
 according to the records of this office.

GABBERT-JONES, INC.

James S. Sutton II
 JAMES S. SUTTON II

Subscribed and sworn to before me this 24th day of August, 1977.

Elizabeth J. Edwards
 ELIZABETH J. EDWARDS-NOTARY PUBLIC

My Commission Expires February 6, 1979.



RECEIVED
 STATE CORPORATION COMMISSION

JUL 13 1978

CONSERVATION DIVISION
 Wichita, Kansas

State Corp