


STATE OF KANSAS
STATE CORPORATION COMMISSION

WELL PLUGGING RECORD

Give All Information Completely
Make Required Affidavit
Mail or Deliver Report to:
Conservation Division
State Corporation Commission
212 North Market, Insurance Bldg.
Wichita, Kansas

NORTH

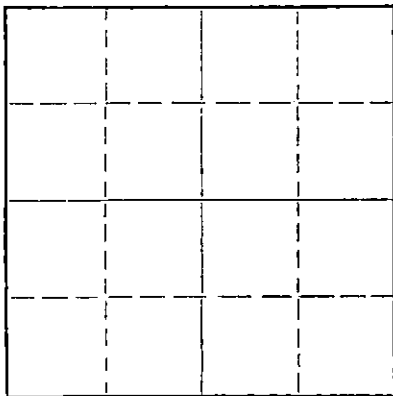

Locate well correctly on above
Section Plat

Ford County, Sec. 25 Twp. 25 Rge. ~~NE~~ 21 (W)
Location as "NE/CNW/SW" or footage from lines C NE SW
Lease Owner Imperial Oil Company
Lease Name Herrmann Well No. 1
Office Address 780 Fourth National Bldg., Wichita, Kansas
Character of Well (completed as Oil, Gas or Dry Hole) Dry Hole
Date well completed June 2, 1961 19
Application for plugging filed June 2, 1961 19
Application for plugging approved June 2, 1961 19
Plugging commenced June 2, 1961 19
Plugging completed June 2, 1961 19
Reason for abandonment of well or producing formation No commercial quantities of oil found.
If a producing well is abandoned, date of last production 19
Was permission obtained from the Conservation Division or its agents before plugging was commenced? Yes

Name of Conservation Agent who supervised plugging of this well Mr. Frank Broadfoot
Producing formation _____ Depth to top _____ Bottom _____ Total Depth of Well 4824 Feet
Show depth and thickness of all water, oil and gas formations.

OIL, GAS OR WATER RECORDS

CASING RECORD

FORMATION	CONTENT	FROM	TO	SIZE	PUT IN	PULLED OUT
				8-5/8"	257'	Not pulled

Describe in detail the manner in which the well was plugged, indicating where the mud fluid was placed and the method or methods used in introducing it into the hole. If cement or other plugs were used, state the character of same and depth placed, from _____ feet to _____ feet for each plug set.

Set first plug at 550 feet with 20 sacks of cement; set second plug at 250 feet with 15 sacks of cement; set top plug at 40 feet with 10 sacks of cement.

RECEIVED
STATE CORPORATION COMMISSION
JUN 29 1961
CONSERVATION DIVISION
Kansas

(If additional description is necessary, use BACK of this sheet)

Name of Plugging Contractor Imperial Oil of Kansas, Inc.
Address 780 Fourth National Building, Wichita 2, Kansas

STATE OF KANSAS, COUNTY OF SEDGWICK, ss.
William A. Sladek (employee of owner) or (owner or operator) of the above-described well, being first duly sworn on oath, says: That I have knowledge of the facts, statements, and matters herein contained and the log of the above-described well as filed and that the same are true and correct. So help me God.
IMPERIAL OIL COMPANY
(Signature) *William A. Sladek* prod. Geol.
780 Fourth Natl. Bldg., Wichita, Kansas
(Address)

SUBSCRIBED AND SWORN TO before me this 8th day of June, 1961
Bette J. Behrmer
Notary Public.

My commission expires July 27, 1964

Re
DRILLER'S LOG

Imperial Oil Company
780 Fourth National Building
Wichita 2, Kansas

Herrman No. 1
C NE SW Sec. 25-25S-21W
Ford County, Kansas

Total Depth: 4824'

Elevation: 2276 K.B.

Commenced: 5-18-61 Completed: 6-2-61

Production: Dry

Contractor: Imperial Oil of Kansas, Inc.
Wichita 2, Kansas

Casing Record: Set 8-5/8" surface pipe at 257' with 125 sacks cement.

Figures indicate bottom of formations:

Shale & Shells	300'
Sand & Shale	820'
Sand, Shells & Shale	1380'
Shale & Shells	2280'
Shale & Lime	2905'
Lime & Shale	4092'
Lime	4824'
Rotary Total Depth	4824'

	<u>TOPS</u>	(Elec. Log)
Heebner	3988	(-1712)
Brown Lime	4096	(-1820)
Lansing	4107	(-1831)
Cherokee Shale	4611	(-2335)
Conglomerate	4731	(-2455)
Mississippian	4744	(-2468)
(Warsaw)		
Mississippian	4752	(-2476)
(Osage)		
Total Depth	4822	(-2546)

We hereby certify this to be a correct and accurate log of the above described test well, as shown by the daily drilling reports.

IMPERIAL OIL COMPANY

By Raymond L. Bacon
Raymond L. Bacon

Subscribed and sworn to before me this 8th day of June, 1961.

My Commission Expires July 27, 1964
RECEIVED
STATE CORPORATION COMMISSION
JUN 29 1961
CONSERVATION DIVISION
Wichita, Kansas

Bette J. Behymer
Bette J. Behymer, Notary Public