


15-057-60017-0000

STATE OF KANSAS
STATE CORPORATION COMMISSION
Give All Information Completely
Make Required Affidavit
Mail or Deliver Report to:
Conservation Division
State Corporation Commission
211 No. Broadway
Wichita, Kansas

WELL PLUGGING RECORD

NORTH

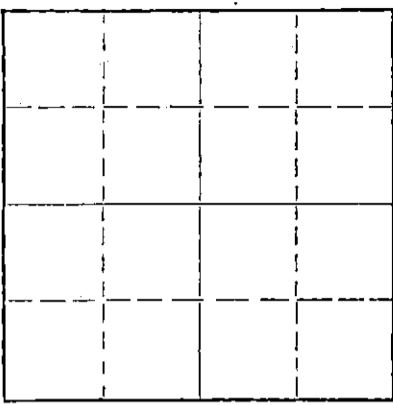

Locate well correctly on above Section Plat

Ford County. Sec. 5 Twp. 26S Rge. 21 (E) W (W)
Location as "NE/CNW%SW%" or footage from lines SE SE SE
Lease Owner Aurora Gasoline Company
Lease Name Issinghoff Well No. 1
Office Address 1107 Union National Bank Building, Wichita, Kansas
Character of Well (completed as Oil, Gas or Dry Hole) Dry Hole
Date well completed May 10 19 57
Application for plugging filed " " 19 57
Application for plugging approved " " 19 57
Plugging commenced " " 19 57
Plugging completed " " 19 57
Reason for abandonment of well or producing formation _____

If a producing well is abandoned, date of last production _____ 19____
Was permission obtained from the Conservation Division or its agents before plugging was commenced? Yes

Name of Conservation Agent who supervised plugging of this well M. A. Rives, Box 8, Pratt, Kansas
Producing formation None Depth to top _____ Bottom _____ Total Depth of Well 4900 Feet
Show depth and thickness of all water, oil and gas formations.

OIL, GAS OR WATER RECORDS

CASING RECORD

FORMATION	CONTENT	FROM	TO	SIZE	PUT IN	PULLED OUT
Surface Hole	Water	0	423	8 5/8"	423'	None
See attached log						

Describe in detail the manner in which the well was plugged, indicating where the mud fluid was placed and the method or methods used in introducing it into the hole. If cement or other plugs were used, state the character of same and depth placed, from _____ feet to _____ feet for each plug set.

Mud from 4900' to 410': Bridge with 20 sacks cement through drill pipe; mud to 35' and bridged hole with 10 sacks cement.

5-23-57

(If additional description is necessary, use BACK of this sheet)

Name of Plugging Contractor Rex & Morris Drilling Company,
Address P. O. Box 334, El Dorado, Kansas

STATE OF Kansas, COUNTY OF Butler, ss.
C. E. McClure (employee of owner) or (owner or operator) of the above-described well, being first duly sworn on oath, says: That I have knowledge of the facts, statements, and matters herein contained and the log of the above-described well as filed and that the same are true and correct. So help me God.

(Signature) C. E. McClure
Box 334, El Dorado, Kansas
(Address)

SUBSCRIBED AND SWORN TO before me this 22nd day of May 19 57.

My commission expires July 23, 1960

Winifred E. Cruik
Winifred E. Cruik Notary Public.

PLUGGING
FILE SEC 5 T. 26 R. 21W
BOOK PAGE 12 LINE 21

15-057-00017-0000

Elevation - 2315 DF
2318 RB

ISSINGHOFF WELL # 1

AURORA GASOLINE COMPANY ETAL

Total Depth - 4900
Contractor - Rex & Morris Drilling Co.
Commenced - 4-26-57
Completed - 5-10-57
Initial Production - D & A

Location - SE SE SE
Section - 5-26S-21W
Ford County, Kansas

Casing Record:
8 5/8" @ 423 Ft. w/ 210 Sacks

FORMATION	DEPTH
Surface Hole	423
Shale	765
Shale & Red Bed	1360
Lime & Shale	1410
Shale & Shells	2080
Shale & Lime	2280
Lime & Shale	2765
Shale & Lime	2861
Lime & Shale	3100
Shale & Lime	3655
Lime & Shale	4140
Lime	4668
Lime & Shale	4722
Shale & Lime	4777
Lime & Shale	4790
Lime	4900 TD

Schlumberger

I hereby certify the foregoing statements are true and correct to the best of my knowledge and belief.

Rex & Morris Drilling Company

By Carroll Wood

Title Lease

STATE OF KANSAS)
) SS.
COUNTY OF BUTLER)

Subscribed and sworn to before me, a Notary Public, this 22 day of May 1957.

Winfred E. Overt
Notary Public

My commission expires
July 23, 1960

PLUGGING
FILE SEC 5 T 26 R 21W
PAGE 12 LINE 21

CONSERVATION DIVISION
Wichita, Kansas