

STATE OF KANSAS  
STATE CORPORATION COMMISSION


Give All Information Completely  
Make Required Affidavit  
Mail or Deliver Report to:  
Conservation Division  
State Corporation Commission  
211 No. Broadway  
Wichita, Kansas

WELL PLUGGING RECORD

Ford County, Sec. 8 Twp. 26S Rge. 21W (E) (W)

Location as "NE/CNW/SW" or footage from lines C SW SE  
Lease Owner Imperial Oil Company  
Lease Name ACKERMAN Well No. 1  
Office Address 780 Fourth Natl. Bldg., Wichita, Kansas  
Character of Well (completed as Oil, Gas or Dry Hole) Dry hole  
Date well completed 8/5/63 19\_\_  
Application for plugging filed 8/5/63 19\_\_  
Application for plugging approved 8/5/63 19\_\_  
Plugging commenced 8/5/63 19\_\_  
Plugging completed 8/5/63 19\_\_  
Reason for abandonment of well or producing formation  
No commercial quantities of oil found  
If a producing well is abandoned, date of last production --- 19\_\_  
Was permission obtained from the Conservation Division or its agents before plugging was commenced? Yes

NORTH

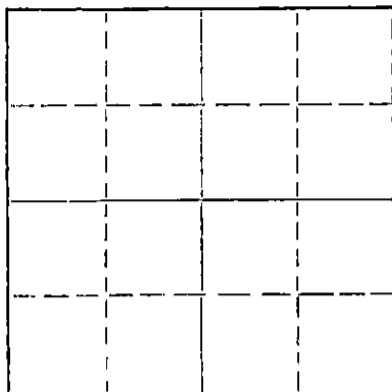

Locate well correctly on above Section Plat

Name of Conservation Agent who supervised plugging of this well Hugh Scott, Liberal, Kansas  
Producing formation -- Depth to top --- Bottom --- Total Depth of Well 4967 Feet  
Show depth and thickness of all water, oil and gas formations.

OIL, GAS OR WATER RECORDS

CASING RECORD

FORMATION	CONTENT	FROM	TO	SIZE	PUT IN	PULLED OUT
	Surface Casing	8-5/8"	at 310'	not pulled		

Describe in detail the manner in which the well was plugged, indicating where the mud fluid was placed and the method or methods used in introducing it into the hole. If cement or other plugs were used, state the character of same and depth placed, from \_\_\_\_\_ feet to \_\_\_\_\_ feet for each plug set.

Set first plug at 500' with 25 sacks

Set second plug at 300' with 20 sacks

Set top plug at 40' with 10 sacks cement

RECEIVED  
STATE CORPORATION COMMISSION

AUG 16 1963

8-16-63

CONSERVATION DIVISION  
Wichita, Kansas

(If additional description is necessary, use BACK of this sheet)

Name of Plugging Contractor \_\_\_\_\_  
Address \_\_\_\_\_

STATE OF Kansas, COUNTY OF Sedgwick, ss.  
Raymond R. Dombaugh (employee of owner) or (owner or operator) of the above-described well, being first duly sworn on oath, says: That I have knowledge of the facts, statements, and matters herein contained and the log of the above-described well as filed and that the same are true and correct. So help me God.

(Signature) Raymond R. Dombaugh  
780 Fourth Natl. Bldg., Wichita, Ks.  
(Address)

SUBSCRIBED AND SWORN TO before me this 15th day of August, 19 63

My commission expires July 5, 1966

Bette J. Silcott  
Bette J. Silcott Notary Public.



DRILLER'S LOG

Imperial Oil Company  
780 Fourth National Building  
Wichita, Kansas

15-057-00120-0000

NO. 1 ACKERMAN  
C SW SE Sec. 8-26S-21W  
Ford County, Kansas

Total Depth: 4967'

Elevation: 2330 K.B.

Commenced: 7/20/63 Completed: 8/4/63

Production: dry

Contractor: Imperial Oil of Kansas, Inc.  
Wichita, Kansas

Casing Record: Set 8-5/8" surface pipe at 310' with 275 sacks cement.

Figures indicate bottom of formations:

Tops

Surface Shale & Sand	310'	Heebner	4067 (-1737)
Shale & Shells	2060'	Toronto	4094 (-1764)
Shale & Lime	4300'	Brown Lime	4177 (-1847)
Lime	4411'	Lansing	4187 (-1857)
Lime & Shale	4520'	Cherokee Shale	4703 (-2373)
Lime	4554'	Miss. (spergen)	4835 (-2505)
Lime & Shale	4589'	Warsaw	4880 (-2550)
Lime	4570'	Osage	4944 (-2614)
Lime & Shale	4719'	RTD	4967 (-2637)
Lime	4950'		
Lime & Chert	4967'		

We hereby certify this to be a correct and accurate log of the above described well, as shown on the daily drilling reports.

IMPERIAL OIL COMPANY

*Raymond R. Dombaugh*  
Raymond R. Dombaugh

Subscribed and sworn to before me this 15th day of August, 1963.

My Commission Expires **RECEIVED**  
STATE CORPORATION COMMISSION

July 5, 1966

AUG 16 1963

*Bette J. Silcott*  
Bette J. Silcott, Notary Public

CONSERVATION DIVISION  
Wichita, Kansas