


15.057: 00042-0000

WELL PLUGGING RECORD

Give All Information Completely
Make Required Affidavit
Mail or Deliver Report to:
Conservation Division
State Corporation Commission
211 No. Broadway
Wichita, Kansas

Ford County. Sec. 30 Twp. 26S Rge. (E) 23 (W)

NORTH

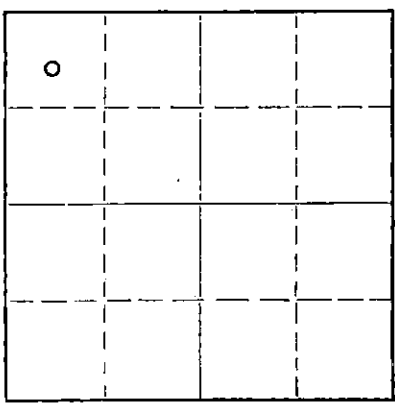

Locate well correctly on above Section Plat

Location as "NE/CNW/SW" or footage from lines C NW NW
Lease Owner Sun Oil Company
Lease Name A. J. Koechner Well No. 1
Office Address Box 1348, Tulsa, Oklahoma
Character of Well (completed as Oil, Gas or Dry Hole) Dryhole
Date well completed 6-10 19.61
Application for plugging filed 6-10 19.61
Application for plugging approved 6-10 19.61
Plugging commenced 6-10 19.61
Plugging completed 6-11 19.61

Reason for abandonment of well or producing formation _____
If a producing well is abandoned, date of last production _____ 19____
Was permission obtained from the Conservation Division or its agents before plugging was commenced? Yes

Name of Conservation Agent who supervised plugging of this well Mr. Frank Broadfoot
Producing formation None Depth to top _____ Bottom _____ Total Depth of Well 5826 Feet
Show depth and thickness of all water, oil and gas formations.

OIL, GAS OR WATER RECORDS

CASING RECORD

FORMATION	CONTENT	FROM	TO	SIZE	PUT IN	PULLED OUT	
Miss. ls.	D.S.T.	Salt wtr.	4989	5039	8-5/8	535'	None

Describe in detail the manner in which the well was plugged, indicating where the mud fluid was placed and the method or methods used in introducing it into the hole. If cement or other plugs were used, state the character of same and depth placed, from _____ feet to _____ feet for each plug set.

Hole filled w/mud. Twenty sack cement plug 244'-300' and fifteen sack cement plug 0-35'. A steel plate was welded on top of 8-5/8" surface casing.

RECEIVED
STATE CORPORATION COMMISSION

APR 9 1963
4-9-63
CONSERVATION DIVISION
Wichita, Kansas

(If additional description is necessary, use BACK of this sheet)

Name of Plugging Contractor Gabbert-Jones, Inc.
Address 514 Orpheum Bldg., Wichita, Kansas

STATE OF OKLAHOMA, COUNTY OF TULSA, ss.
J. H. Allen (employee of owner) or (owner or operator) of the above-described well, being first duly sworn on oath, says: That I have knowledge of the facts, statements, and matters herein contained and the log of the above-described well as filed and that the same are true and correct. So help me, God.

(Signature) J. H. Allen
Box 1348, Tulsa, Oklahoma
(Address)

SUBSCRIBED AND SWORN TO before me this 8th day of April, 1963

W. J. Goodner
Notary Public.

My commission expires JUN 28 1964



DRILLERS' LOG
 SUN OIL COMPANY
 A. J. Koechner No. 1
 NW/4 NW/4
 Sec. 30, Twp. 26S, Rge. 23W
 Ford County, Kansas

15-057-00042-0000

<u>FORMATION</u>	<u>FROM</u>	<u>TO</u>	
Shale, sand, lime	0	280	Spud Date: 5-13-61
Shale and lime	280	2652	
Krider lime & shale	2652	2682	8-5/8" 24# J55 csg. set at 535' w/450 sax cement.
Winfield Lime & shale	2682	2713	
Towanda Lime & shale	2713	2766	
Fort Riley Lime & shale	2766	2840	DST #1: 4989-5039' open 1-3/4 hrs., rec. 1575' salt water.
Lime and shale	2840	4186	ISIP 1460#; FSIP 1500#; IFP 35#-104# FFP 97# - 623#
Heebner Lime & shale	4186	4302	
Lansing Lime & shale	4302	4758	
Marmaton Lime & shale	4758	4842	
Cherokee	4842	4986	
Miss. Lime	4986	5480	
Kinderhook	5480	5620	
Viola	5620	5720	
Simpson Sand	5720	5792	
Arbuckle Lime	5792	5826	
		T.D.	

RECEIVED
 STATE CORPORATION COMMISSION
 JUN 27 1961
 CONSERVATION DIVISION
 Wichita, Kansas

I hereby certify that the foregoing is a true and correct copy of the A. J. Koechner No. 1 Well log as recorded on the books of Sun Oil Company, Tulsa, Oklahoma

J. H. Allen

 J. H. Allen, Asst. Prod. Supt.

STATE OF OKLAHOMA)
) SS
 COUNTY OF TULSA)

Subscribed and sworn to before me this 26 day of June, 1961.

W. F. Goodner

 W. F. GOODNER Notary Public

My Commission Expires:

JUN 28 1964