


Give All Information Completely
Make Required Affidavit
Mail or Deliver Report to:
Conservation Division
State Corporation Commission
212 North Market, Insurance Bldg.
Wichita, Kansas

Le

WELL PLUGGING RECORD

Ford County. Sec. 21 Twp. 26S Rge. R23W (E) (W)

Location as "NE/CNW/SW" or footage from lines C SE NW
Lease Owner Aikman Brothers
Lease Name Giessel Well No. 1
Office Address 622 Barfield Bldg, Amarillo, Texas
Character of Well (completed as Oil, Gas or Dry Hole) Dry Hole
Date well completed 12/21/60 19
Application for plugging filed _____ 19
Application for plugging approved oral permission obtained 12/21/60
Plugging commenced 12/21/60 19
Plugging completed 12/21/60 19
Reason for abandonment of well or producing formation dry hole

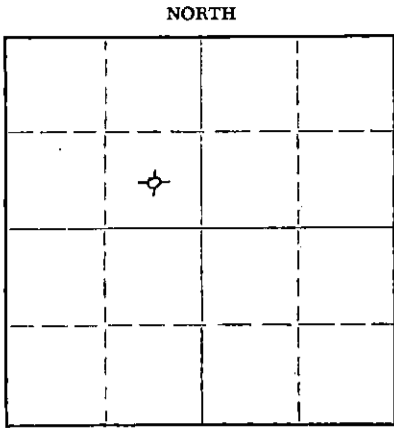

Locate well correctly on above Section Flat

If a producing well is abandoned, date of last production _____ 19
Was permission obtained from the Conservation Division or its agents before plugging was commenced? yes

Name of Conservation Agent who supervised plugging of this well _____
Producing formation none Depth to top _____ Bottom _____ Total Depth of Well 2900 Feet
Show depth and thickness of all water, oil and gas formations.

OIL, GAS OR WATER RECORDS

CASING RECORD

FORMATION	CONTENT	FROM	TO	SIZE	PUT IN	PULLED OUT
				8-5/8"	453'	none

Describe in detail the manner in which the well was plugged, indicating where the mud fluid was placed and the method or methods used in introducing it into the hole. If cement or other plugs were used, state the character of same and depth placed, from _____ feet to _____ feet for each plug set.

Plugged at 350' with 20 sacks of cement and 1/3 sack of hulls, filled with mud to 35', plugged with 10 sacks of cement and 1/3 sack of hulls.

FILED
STATE CORPORATION COMMISSION
JAN 25 1961
1-25-61
CONSERVATION DIVISION
Wichita, Kansas

(If additional description is necessary, use BACK of this sheet)
Name of Plugging Contractor Strata Drilling, Inc.
Address Great Bend, Kansas

STATE OF Texas COUNTY OF Potter, ss.
R. E. Aikman (employee of owner) or (owner or operator) of the above-described well, being first duly sworn on oath, says: That I have knowledge of the facts, statements, and matters herein contained and the log of the above-described well as filed and that the same are true and correct. So help me God.

(Signature) *Robert Aikman*
622 Barfield Building, Amarillo, Tex.
(Address)

SUBSCRIBED AND SWORN TO before me this 23rd day of January, 19 61.

My commission expires 6/1/61
Rose Ann Davis
Notary Public.



DRILLERS LOG

#1 Giessel

15-057-00062-0000

CASING RECORD: 446.45' of new 8-5/8" surface casing
 COMPANY: Aikman Bros.
 DESCRIPTION: C/ SE NW Section 21-26S-23W Ford County, Kansas
 CONTRACTOR: Strata Drilling, Inc.
 TOTAL DEPTH: 2900'
 COMMENCED: December 15, 1960
 COMPLETED: December 21, 1960

D. & A.

<u>FORMATION</u>	<u>FROM</u>	<u>TO</u>	<u>REMARKS</u>
Shale	0	455	Ran 446.45' of new 8-5/8" surface casing; set and cemented at 453' with 225 sacks of cement, 2% C. C. and 3% gel. Plug down at 12:00 noon 12-16-1960. Cement circ.
Shale & Red Bed	455	955	
Shale	955	1595	
Lime & Shale	1595	2900	
Total Depth 2900'			

RECEIVED
 STATE COMMISSION
 JAN 25 1961
 CONSERVATION DIVISION
 Wichita, Kansas


D. & A.

Hole plugged as follows: Plugged at 350' with 20 sacks of cement and 1/3 sack of hulls, filled with mud to 35' plugged with 10 sacks of cement and 1/3 sack of hulls. Plug down at 10:30 A. M. 12-21-1960.

STATE OF KANSAS)
) ss.
 COUNTY OF BARTON)

I certify that this is a true and correct copy of the above log to the best of my knowledge.

STRATA DRILLING, INC.

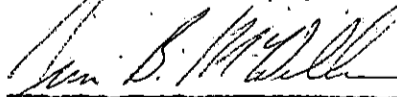
 Jim B. McWilliams, Secy-Treas.

Subscribed and sworn to before me this 23rd of December, 1960.


 Elaine H. Taylor, Notary Public

My Commission Expires:
 December 14, 1961