


STATE OF KANSAS
STATE CORPORATION COMMISSION

WELL PLUGGING RECORD

Give All Information Completely
Make Required Affidavit
Mail or Deliver Report to:
Conservation Division
State Corporation Commission
800 Bitting Building
Wichita, Kansas

NORTH

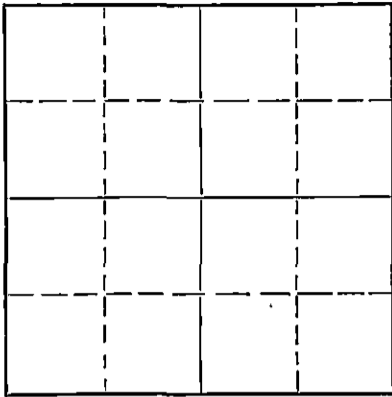

Locate well correctly on above
Section Plat

Reno County. Sec. 15 Twp. 25S Rge. 4 (E) (W)
Location as "NE/CNW/SW" or footage from lines NE NW NW
Lease Owner Durbin Bond and Company, Inc.
Lease Name #1 D. Meyer Well No. 1
Office Address Union National Bank Bldg., Little Rock, Arkansas
Character of Well (completed as Oil, Gas or Dry Hole) Dry Hole
Date well completed July 21, 19 53
Application for plugging filed July 21 19 53
Application for plugging approved July 21 19 53
Plugging commenced July 21 19 53
Plugging completed July 21 19 53
Reason for abandonment of well or producing formation Dry Hole.

If a producing well is abandoned, date of last production 19
Was permission obtained from the Conservation Division or its agents before plugging was commenced? Yes.

Name of Conservation Agent who supervised plugging of this well Ruel E. Durkee
Producing formation Depth to top Bottom Total Depth of Well 4100 Feet
Show depth and thickness of all water, oil and gas formations.

OIL, GAS OR WATER RECORDS

CASING RECORD

FORMATION	CONTENT	FROM	TO	SIZE	PUT IN	PULLED OUT
				8-5/8"	283'	

Describe in detail the manner in which the well was plugged, indicating where the mud fluid was placed and the method or methods used in introducing it into the hole. If cement or other plugs were used, state the character of same and depth placed, from feet to feet for each plug set.

Lay down half of drill pipe and filled hole with heavy mud. Finish laying down drill pipe. Set solid bridge at 270'; cemented through 9 joints of drill pipe with 15 sacks cement. Filled hole to 25'. Cemented with 5 sacks cement.

STATE OF KANSAS
Conservation Division

7-23-53

(If additional description is necessary, use BACK of this sheet)

Name of Plugging Contractor Group Exploration Company
Address P. O. Box 218 - Sterling, Kansas

STATE OF Kansas, COUNTY OF Rice, ss.
Rollin Mead (employee of owner) or (operator) of the above-described well, being first duly sworn on oath, says: That I have knowledge of the facts, statements, and matters herein contained and the log of the above-described well as filed and that the same are true and correct. So help me God.

(Signature) Rollin Mead

P. O. Box 218, Sterling, Kansas
(Address)

SUBSCRIBED AND SWORN TO before me this 22nd day of July, 19 53

My commission expires

June 2, 56
PLUGGING
FRI SEC 15 T R 40
BOOK PAGE 16 LINE 39

24-7368-8 3-53-20M

Notary Public.

Herb M. Pearson

GROUP EXPLORATION CO.

BOX 218
STERLING, KANSAS

WELL LOG ----- #1 D. Meyer

Location - NE NW NW Section 15, Township 25S, Range 4 West,
Reno County, Kansas.

OWNER: Durbin Bond and Company, Inc.
ROTARY DRILLING CONTRACTOR: Group Exploration Company

Commenced: July 3, 1953
Completed: July 21, 1953

Total Depth: 4100'

Elevation: 1478 DF
1476 GR

LOG

0- 50	Shale
50- 75	Sand
75- 282	Shale and Shells
282- 465	Shale and Lime
465- 715	Shale, Lime, and Salt
715- 855	Lime
855-1100	Lime and Shale
1100-1260	Lime
1260-1470	Shale and Lime
1470-1680	Shale and Shells
1680-1975	Shale and Lime
1975-2150	Shale and Shells
2150-2775	Lime and Shale
2775-3395	Lime
3395-3535	Shale
3535-3550	Lime
3550-3590	Shale and Lime
3590-3630	Mississippi Chert
3630-3840	Lime
3840-3875	Shale
3875-3940	Lime and Shale
3940-3980	Shale
3980-3985	Viola Lime
3985-3990	Lime
3990-4040	Sand and Shale
4040-4070	Lime and Shale
4070-4087	Sand and Lime
4087-4100	Lime

CASING RECORD:
283' of 8-5/8" Surface Pipe
set at 279'. Cemented with
175 sacks Cement, 2 sacks
calcium chloride.

PRODUCTION: Dry and Abandoned.

PLUGGING
 FILE SEC. 15-7-25 NW 4W
 CORR. PAGE 116 LINE 39

RECORDED
STATE CORPORATION COMMISSION

JUL 25 1953

CONSERVATION DIVISION
Wichita, Kansas

7-23-53