

STATE OF KANSAS  
STATE CORPORATION COMMISSION

WELL PLUGGING RECORD

Give All Information Completely  
Make Required Affidavit  
Mail or Deliver Report to:  
Conservation Division  
State Corporation Commission  
800 Biting Building  
Wichita, Kansas

Reno County. Sec. 17 Twp. 25 Rge. (E) 4 (W)

Location as "NE/CNW/SW" or footage from lines NW 1/4 SE 1/4 SW 1/4

Lease Owner Barnett Oil Company, et al

Lease Name Oehlert Well No. 1

Office Address 417 First Nat'l Bank Bldg., Wichita, Kansas

Character of Well (completed as Oil, Gas or Dry Hole) Dry Hole

Date well completed May 13, 1954

Application for plugging filed May 13, 1954

Application for plugging approved May 13, 1954


Plugging commenced May 13, 1954

Plugging completed May 13, 1954

Reason for abandonment of well or producing formation Dry Hole

If a producing well is abandoned, date of last production - - - 19

Was permission obtained from the Conservation Division or its agents before plugging was commenced? Yes

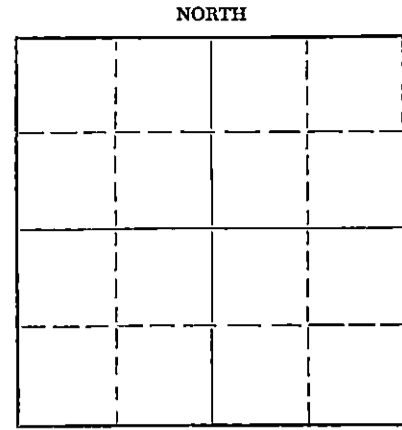

Locate well correctly on above Section Plat

Name of Conservation Agent who supervised plugging of this well Ruel Durkee

Producing formation \_\_\_\_\_ Depth to top \_\_\_\_\_ Bottom \_\_\_\_\_ Total Depth of Well 4100 Feet

Show depth and thickness of all water, oil and gas formations.

OIL, GAS OR WATER RECORDS

CASING RECORD

FORMATION	CONTENT	FROM	TO	SIZE	PUT IN	PULLED OUT
Surface Casing		0	251'	8 5/8"	251'	None

Describe in detail the manner in which the well was plugged, indicating where the mud fluid was placed and the method or methods used in introducing it into the hole. If cement or other plugs were used, state the character of same and depth placed, from \_\_\_\_\_ feet to \_\_\_\_\_ feet for each plug set.

Filled hole with heavy mud from 4100 feet to 240 feet. Set wooden plug at 240 feet and filled surface casing with 1/2 sack of hulls and 15 sacks of cement to 193 feet. Filled casing with heavy mud from 193 feet to 40 feet and set wooden plug at 40 feet. Filled surface casing with 1/2 sack of hulls and 10 sacks of cement to bottom of cellar.

RECEIVED  
STATE CORPORATION COMMISSION  
JUN 2 - 1954  
6-2-54  
CONSERVATION DIVISION  
Wichita, Kansas

(If additional description is necessary, use BACK of this sheet)  
Name of Plugging Contractor Barnett Drilling, Inc.  
Address 623 First Nat'l Bank Bldg., Wichita, Kansas

STATE OF Kansas, COUNTY OF Sedgwick, ss.  
W. R. Hunter (employee of owner) or (owner) of the above-described well, being first duly sworn on oath, says: That I have knowledge of the facts, statements, and matters herein contained and the log of the above-described well as filed and that the same are true and correct. So help me God.

(Signature) W. R. Hunter  
417 First Nat'l Bank Bldg., Wichita, Kansas  
(Address)

SUBSCRIBED AND SWORN TO before me this 1st day of June, 1954

Mildred J. Willis  
Notary Public.

My commission expires February 27, 1956.

PLUGGING  
FILE SEC 17 T25 R 4W  
BOOK PAGE 34 LINE 34

BARNETT OIL COMPANY  
 LOG OF OEHLERT WELL NO. 1  
 NW $\frac{1}{4}$  SE $\frac{1}{4}$  SW $\frac{1}{4}$  SECTION 17-25S-4W  
 RENO COUNTY, KANSAS

DATE COMMENCED: April 20, 1954

DATE COMPLETED: May 13, 1954

Formation	From	To	Remarks
Surface Clay	0	10	
Red Bed	10	80	
Shale	80	130	
Shale and Lime	130	251	Set 8 5/8", 24# Surface Casing at 251'; cemented with 200 sacks of cement.
Shale	251	350	
Shale and Shells	350	650	
Anhydrite	650	800	
Lime and Shale	800	2175	
Lime	2175	2340	
Lime and Shale	2340	2762	
Lime	2762	3190	
Lime and Shale	3190	3515	
Shale and Chert	3515	3530	
Chert	3530	3567	
Chert and Shale	3567	3634	
Lime	3634	3660	
Chert and Lime	3660	3748	
Lime	3748	3785	
Lime and Shale	3785	3935	
Shale	3935	3976	
Lime	3976	3990	
Lime and Shale	3990	3996	
Sand, Lime and Shale	3996	4067	
Lime and Shale	4067	4083	
Lime	4083	4100	
Total Depth		4100	Dry and Abandoned.

**RECEIVED**  
 STATE CORPORATION COMMISSION  
 JUN 2 - 1954  
 CONSERVATION DIVISION  
 Wichita, Kansas

6-2-54

