


STATE OF KANSAS
STATE CORPORATION COMMISSION

WELL PLUGGING RECORD

Give All Information Completely
Make Required Affidavit
Mail or Deliver Report to:
Conservation Division
State Corporation Commission
800 Bittling Building
Wichita, Kansas

Reno County, Sec. 19 Twp. 24 Rge. 10 ~~XX~~ (W)
Location as "NE/CNW/SW" or footage from lines SE/4 SE/4 SW/4
Lease Owner Lee Phillips Oil Company
Lease Name McVey Well No. One
Office Address 1407 Union National Bank Bld, Wichita, Kansas
Character of Well (completed as Oil, Gas or Dry Hole) Dry Hole
Date well completed January 20, 1956
Application for plugging filed January 20, 1956
Application for plugging approved January 20, 1956
Plugging commenced January 20, 1956
Plugging completed January 20, 1956
Reason for abandonment of well or producing formation Dry hole

NORTH

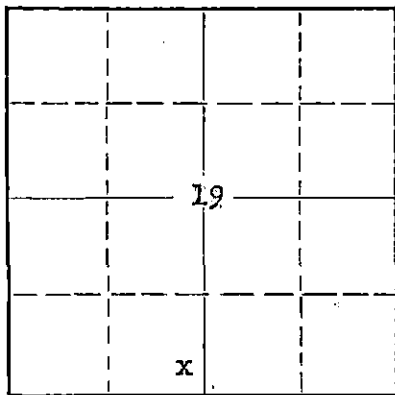

Locate well correctly on above
Section Plat

If a producing well is abandoned, date of last production 19
Was permission obtained from the Conservation Division or its agents before plugging was com-
menced? yes

Name of Conservation Agent who supervised plugging of this well Milton Galyardt
Producing formation Depth to top Bottom Total Depth of Well 1150 Feet
Show depth and thickness of all water, oil and gas formations.

OIL, GAS OR WATER RECORDS

CASING RECORD

FORMATION	CONTENT	FROM	TO	SIZE	PUT IN	PULLED OUT
				8 5/8"	230'	None

Describe in detail the manner in which the well was plugged, indicating where the mud fluid was placed and the method or methods used in introducing it into the hole. If cement or other plugs were used, state the character of same and depth placed, from feet to feet for each plug set.

Filled hole to 220' with heavy mud, drove plug to 220' and cemented with 15 sacks cement on top of plug. Drove plug to 20', cemented with 5 sacks cement.

(If additional description is necessary, use BACK of this sheet)

Name of Plugging Contractor Anschutz Drilling Co., Inc.
Address 1411 Mile High Center, Denver, Colorado

STATE OF COLORADO, COUNTY OF DENVER, ss.
E. G. Koelling (employee of owner) or (owner or operator) of the above-described well, being first duly sworn on oath, says: That I have knowledge of the facts, statements, and matters herein contained and the log of the above-described well as filed and that the same are true and correct. So help me God.

(Signature) E. G. Koelling
1411 Mile High Center, Denver, Colorado (Address)

SUBSCRIBED AND SWORN TO before me this 7th day of February, 19 56

My commission expires October 4, 1959
[Signature] Notary Public.

PLUGGING
FILE SEC 19 T 24 R 10W
BOOK PAGE 33 LINE 9

2-9-56

