


STATE OF KANSAS  
STATE CORPORATION COMMISSION

WELL PLUGGING RECORD

Give All Information Completely  
Make Required Affidavit  
Mail or Deliver Report to:  
Conservation Division  
State Corporation Commission  
800 Bittling Building  
Wichita, Kansas

OR  
FORMATION PLUGGING RECORD

Strike out upper line  
when reporting plug-  
ging off formations.

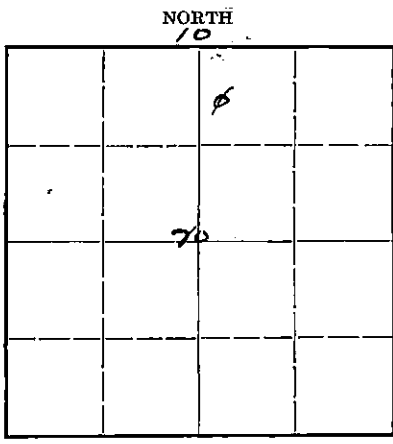

Reno County Sec. 20 Twp. 24 Rge. 10 (E) (W)  
Location as "NE1/4NW1/4SW1/4" or footage from lines C. W. L. NW NE1/4  
Lease Owner H. A. Hershfield & Co., Inc.,  
Lease Name Thompson Well No. 1  
Office Address Wolcott Bldg. - Hutchinson, Kansas  
Character of Well (completed as Oil, Gas or Dry Hole) Dry  
Date well completed May 28 19 46  
Application for plugging filed " 19 46  
Application for plugging approved " 19 46  
Plugging commenced " 19 46  
Plugging completed " 19 46  
Reason for abandonment of well or producing formation

Locate well correctly on above  
Section Plat

Name of Conservation Agent who supervised plugging of this well Ruel Dirke  
Producing formation Depth to top Bottom Total Depth of Well 4103 Feet  
Show depth and thickness of all water, oil and gas formations.

CASING RECORD

Formation	Content	From	To	Size	Put In	Pulled Out
				10 3/4	210	-

Describe in detail the manner in which the well was plugged, indicating where the mud fluid was placed and the method or methods used in introducing it into the hold. If cement or other plugs were used, state the character of same and depth placed, from feet to feet for each plug set.

Filled with Heavy Rotary mud 4103 to 200'  
20 sacks cement - Filled with extra heavy mud to 15' - 5  
sacks cement

Handwritten notes: 20 24 10W, 56 20  
Stamp: STATE CORPORATION COMMISSION JUN - 3 1946 6-3-46

(If additional description is necessary, use BACK of this sheet)  
Correspondence regarding this well should be addressed to H. A. Hershfield & Co., Inc.,  
Address Wolcott Bldg. - Hutchinson, Kansas

STATE OF \_\_\_\_\_, COUNTY OF \_\_\_\_\_, SS.  
\_\_\_\_\_ (employee of owner) or (owner or operator) of the above-described well,  
being first duly sworn on oath, says: That I have knowledge of the facts, statements, and matters herein contained and the log of the above-described well as filed and that the same are true and correct. So help me God.

(Signature) *Laura Walker*

(Address)

SUBSCRIBED AND SWORN to before me this 31st day of May, 1946

NOTARY PUBLIC

My Commission Expires March 20, 1950

*Laura Walker*  
Notary Public.

My commission expires

DRILLING LOG

Thompson No. 1 Well NW $\frac{1}{4}$  NE $\frac{1}{4}$  20-24-10  
 Reno County, Kansas

DRILLED FOR: H. A. HERSHFIELD & CO, INC.,  
 DRILLED BY: PULSE-HERSHFIELD DRILLING CO, INC.,

COMMENCED: April 28, 1946  
 COMPLETED: May 29, 1946

Surface and Sand	80
Red Rock	210
Red Rock and shells	770
Anhydrite	780
Shales & Shells	1013
Salt	1055
Shale and shells	1620
Broken Lime	1656
Lime (Sandy)	1680
Broken Lime	2230
Lime	2282
Broken Lime	2580
Lime	2684
Broken Lime	2858
Lime	3164
Shale and shells	3186
Shale	3234
Sandy Shale	3259
Shale	3279
Shale and shells	3372
Lime	3520
Shale and shells	3565
Lime	3600
Shale and shells	3738
Lime	3762
Shale	3886
Lime (Viola)	3971
Cored	3898 - 3902
Drill stem test H.2-0	
Shale	3988
Lime	4002
Shale	4010
Sand	4013
Sandy shale	4030
Sand	4060
Sandy Lime	4068
Lime - Arbuckle	4103 - D & A
Cored	4070 - 4074†

Casing Record  
 10 3/4 210' Cemented 225 Sacks


I, Clyde Pulse, of lawful age, being President of the Pulse-Hershfield Drilling Co, Inc., hereby certify that the above is a true and correct log of the formations encountered in the drilling of the above well as taken from the daily drilling reports thereof. That the above cores were taken and a drill stem test, Halliburton Electric Log, and that the same has been plugged and abandoned by authority of the State Corporation Commission Oil and Gas Division in accordance with their rules and regulations. Further, affiant sayeth not.

*Clyde Pulse*

Subscribed and sworn to before me this 21st day of May, 1946,  
 NOTARY PUBLIC

My commission expires My Commission Expires March 20, 1950

*Laura Walker*  
 Notary Public

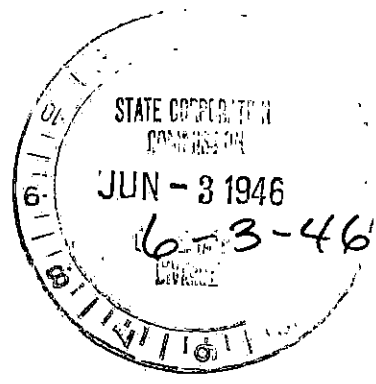

DRILLING  
 20 24 10W  
 56 20

FILE  
 LOCK