

15-155-00010-0000

STATE OF KANSAS
STATE CORPORATION COMMISSION

Give All Information Completely
Make Required Affidavit
Mail or Deliver Report to:
Conservation Division
State Corporation Commission
211 No. Broadway
Wichita, Kansas

WELL PLUGGING RECORD

Reno County, Sec. 31 Twp. 24 Rge. 10 (E) (W)

Location as "NE/CNW&SW" or footage from lines C-NE/4 NW SW

Lease Owner DeMier Oil Co.

Lease Name C. Brownlee "A" Well No. 2

Office Address 2740 E. 41st St., Tulsa 5, Okla.

Character of Well (completed as Oil, Gas or Dry Hole) Dry hole

Date well completed 9/19/56 19

Application for plugging filed 9/19/56 19

Application for plugging approved 9/19/56 19


Plugging commenced 8:00 AM 19

Plugging completed 9:00 AM 19

Reason for abandonment of well or producing formation Dry hole

If a producing well is abandoned, date of last production 19

Was permission obtained from the Conservation Division or its agents before plugging was commenced? Yes

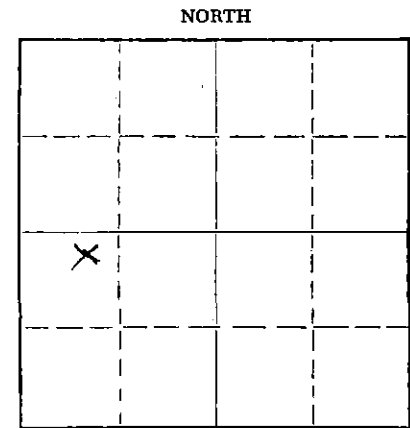

Locate well correctly on above Section Plat

Name of Conservation Agent who supervised plugging of this well Mr. Durkee

Producing formation Depth to top Bottom Total Depth of Well 4,150 Feet

Show depth and thickness of all water, oil and gas formations.

OIL, GAS OR WATER RECORDS

CASING RECORD

FORMATION	CONTENT	FROM	TO	SIZE	PUT IN	PULLED OUT
Surface soil		0'	15'			
Sand & gravel		15'	110'			
Red bed		110'	223'	8-5/8"	223'	None

Describe in detail the manner in which the well was plugged, indicating where the mud fluid was placed and the method or methods used in introducing it into the hole. If cement or other plugs were used, state the character of same and depth placed, from feet to feet for each plug set.

Hole full of heavy mud to 210'

Plug with 1/3 sack hulls at 210'

15 Sx of common cement mixed through drill pipe on plug

Heavy mud to 30'

Plug and hulls at 30'

10 Sx of cement to base of cellar.

(If additional description is necessary, use BACK of this sheet)

Name of Plugging Contractor Badgers Drillers, Inc.
Address P.O. Box 287, Tulsa, Okla.

STATE OF Okla., COUNTY OF Tulsa, ss.
Fred DeMier (employee of owner) or (owner or operator)

of the above-described well, being first duly sworn on oath, says: That I have knowledge of the facts, statements, and matters herein contained and the log of the above-described well as filed and that the same are true and correct. So help me God.

(Signature) Fred DeMier
2740 E. 41st St., Tulsa 5, Okla.

(Address)

SUBSCRIBED AND SWORN to before me this 27th day of Sept., 1956

My commission expires Sept. 24, 1958.

O. E. SPENCER Notary Public.

PLUGGING
FILE SEC 31 T. 24 R. 10W
BOOK PAGE 101 LINE 42

9-28-56

De Hier Oil Company
Drillers Log
C. Brownles #2
NE-1/4-SW Sec. 31-24-10W
Reno County, Kansas

<u>From</u>	<u>To</u>	<u>Formation</u>	<u>Remarks</u>
0	85'	Surface & Sand	
85'	226'	Shale and Red Bed	Ran 227' - 8 5/8" O.D. Casing Set at 226' with 50 Sacks
226'	750'	Red Bed	
750'	1170'	Shale and Shells	
1170'	1500'	Anhydrite	
1500'	1650'	Shale and Shells	
1650'	1760'	Lime and Shale	
1760'	1875'	Lime	
1875'	1915'	Lime and Shale	
1915'	2065'	Lime	
2065'	2940'	Lime and Shale	
2940'	3025'	Lime	
3025'	3387'	Lime and Shale	
3387'	3762'	Lime	
3762'	3767'	Lime and Chert	
3767'	3772'	Lime	
3772'	3791'	Chert	
3791'	3818'	Lime and Chert	
3818'	3928'	Shale	
3928'	3945'	Lime	
3945'	3966'	Lime and Chert	
3966'	4093'	Lime	
4093'	4135'	Simpson Sand & Arbuckle	
4135'	4150'	Arbuckle	Total Depth - Dry Hole

TOPS:

Mississippi	3765'
Kinderhook	3813'
Kisner	3928'
Viola	3934'
Simpson	4050'
Arbuckle	4122'

I certify the above to be a true and exact copy of the Drillers Log as shown by the Daily Drilling Reports.

Don Schubert

Sage Drillers, Inc.

Subscribed and sworn to before me this 20th day of September, 1956.

Chas. Pauline

Notary Public

PLUGGING I V E D	
FILE	SEC 31 T 24 R 10W
BOOK	PAGE 101 LINE 42
OCT 10-19-56	

My commission expires 10-20-57