


STATE OF KANSAS
STATE CORPORATION COMMISSION

Give All Information Completely
Make Required Affidavit
Mail or Deliver Report to:
Conservation Division
State Corporation Commission
211 No. Broadway
Wichita, Kansas

WELL PLUGGING RECORD

NORTH

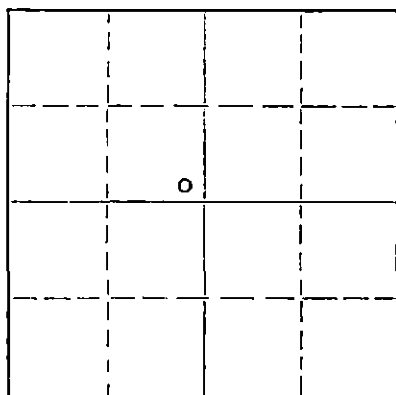

Locate well correctly on above
Section Plat

Reno County. Sec. 31 Twp. 24S Rge. (E) 10 (W)
Location as "NE/CNW/SW" or footage from lines SE/4 SE/4 NW/4
Lease Owner Messman-Rinehart Oil Company
Lease Name Brownlee Well No. 1
Office Address 518 Petroleum Building, Wichita, Kansas
Character of Well (completed as Oil, Gas or Dry Hole) Dry Hole
Date well completed May 12 1958
Application for plugging filed May 12 1958
Application for plugging approved May 12 1958
Plugging commenced May 12 1958
Plugging completed May 12 1958
Reason for abandonment of well or producing formation Dry

If a producing well is abandoned, date of last production 19
Was permission obtained from the Conservation Division or its agents before plugging was commenced? yes

Name of Conservation Agent who supervised plugging of this well Fred W. Hampel, Pretty Prairie, Kansas
Producing formation Depth to top Bottom Total Depth of Well 4072 Feet
Show depth and thickness of all water, oil and gas formations.

OIL, GAS OR WATER RECORDS

CASING RECORD

FORMATION	CONTENT	FROM	TO	SIZE	PUT IN	PULLED OUT
				8-5/8"	242'	none

Describe in detail the manner in which the well was plugged, indicating where the mud fluid was placed and the method or methods used in introducing it into the hole. If cement or other plugs were used, state the character of same and depth placed, from feet to feet for each plug set.

Heavy mud to 200 ft., Set plug with 20 sx.
cement, heavy mud to 40 ft., set plug with
10 sx. cement to surface

RECEIVED

MAY 29 1958
3-29-58
CONSERVATION DIVISION
Wichita, Kansas

(If additional description is necessary, use BACK of this sheet)

Name of Plugging Contractor Messman-Rinehart Oil Company
Address 518 Petroleum Building, Wichita, Kansas

STATE OF Kansas, COUNTY OF Sedgwick, ss.
J. A. Gilliland (employee of owner) of the above-described
well, being first duly sworn on oath, says: That I have knowledge of the facts, statements, and matters herein contained and the log of the
above-described well as filed and that the same are true and correct. So help me God.

(Signature)

518 Petroleum Building, Wichita, Kansas
(Address)

SUBSCRIBED AND SWORN TO before me this 28th day of May, 1958

Barbara J. Scott, Notary Public.

My commission expires December 1, 1960

PLUGGING
FILE SEC 31 T 24 R 10W
BOOK PAGE 101 LINE 33

15-155-00065-0000

WELL LOG BUREAU—KANSAS GEOLOGICAL SOCIETY
508 East Murdock, Wichita, Kansas


Company- MESSMAN-RINEHART OIL CO.
Farm- Brownlee No. 1

SEC. 31 T. 24 R. 10W
SE SE NW

Total Depth. 4072'
Comm. 4-30-58 Comp. 5-12-58
Shot or Treated.
Contractor. Messman-Rinehart Oil
Issued. 7-5-58

County Reno

KANSAS

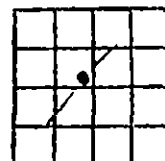

Elevation. 1757' KB

Production. Dry

Figures Indicate Bottom of Formations.

sand	90
red bed & shells	242
red bed	500
shale & shells	825
shale & salt	1150
shale	1260
anhydrite	1295
shale & shells	1555
lime & shale	1760
lime	2050
lime & shale	3125
lime	3205
lime & shale	3420
lime	3505
lime & shale	3525
lime	3560
lime & chert	3595
lime	3650
lime & shale	3772
chert Mississippi	3805
lime & shale	3930
chalk lime	3948
chert	3955
lime & chert	4018
lime	4049
shale & sand	4072 RTI
Total Depth	

TOPS: SAMPLE

Brown, Lima	3375
Lansing	3391
Mississippi	3772
Kinderhook	3811
Viola	3930
Simpson Shale	4049
Simpson Sand (scout)	4066