


STATE OF KANSAS
STATE CORPORATION COMMISSION

Form CP-4

Give All Information Completely
Make Required Affidavit
Mail or Deliver Report to:
Conservation Division
State Corporation Commission
211 No. Broadway
Wichita, Kansas

WELL PLUGGING RECORD

NORTH

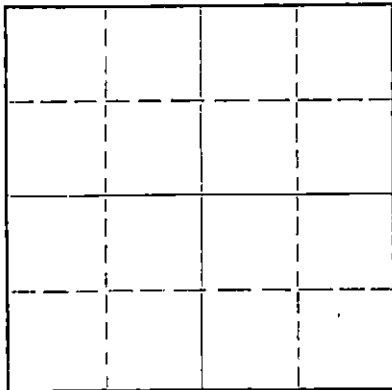

Locate well correctly on above
Section Plat

Reno County, Sec. 3 Twp. 25S. Rge. 4W (N) (W)
Location as "NE/CNW/SW" or footage from lines. C SE NW
Lease Owner. Texstar Petroleum Co.
Lease Name O. P. Gilmore Well No. 1
Office Address 610 Petroleum Bldg., Wichita, Kansas
Character of Well (completed as Oil, Gas or Dry Hole) Dry Hole
Date well completed 12-3-62 19
Application for plugging filed 12-3-62 19
Application for plugging approved 12-3-62 19
Plugging commenced 12-3-62 19
Plugging completed 12-3-62 19
Reason for abandonment of well or producing formation Dry Hole

If a producing well is abandoned, date of last production 19
Was permission obtained from the Conservation Division or its agents before plugging was commenced? yes

Name of Conservation Agent who supervised plugging of this well Herman E. Justus, Nickerson, Kansas
Producing formation _____ Depth to top _____ Bottom _____ Total Depth of Well 4055 Feet
Show depth and thickness of all water, oil and gas formations.

OIL, GAS OR WATER RECORDS

CASING RECORD

FORMATION	CONTENT	FROM	TO	SIZE	PUT IN	PULLED OUT
				8 5/8"	624.90	None

Describe in detail the manner in which the well was plugged, indicating where the mud fluid was placed and the method or methods used in introducing it into the hole. If cement or other plugs were used, state the character of same and depth placed, from _____ feet to _____ feet for each plug set.

Bottom plug set @ 180' with $\frac{1}{2}$ sk. hulls and 20 sks. cement

Top plug set @ 40' with $\frac{1}{2}$ sk. hulls and 10 sks. cement.

DEC 23 1962
12-26-62
CONSERVATION DIVISION
WICHITA, KANSAS

(If additional description is necessary, use BACK of this sheet)

Name of Plugging Contractor Leben Drilling, Inc.
Address P. O. Box 486, Great Bend, Kansas

STATE OF KANSAS, COUNTY OF BARTON, ss.

Byron Johnson (employee of owner) or (owner or operator) of the above-described well, being first duly sworn on oath, says: That I have knowledge of the facts, statements, and matters herein contained and the log of the above-described well as filed and that the same are true and correct. So help me God.

(Signature)

P. O. Box 486, Great Bend, Kansas
(Address)

SUBSCRIBED AND SWORN TO before me this 20th day of December, 19 62

My commission expires

April 1, 1963

Notary Public.



DRILLER'S LOG

COMPANY: Texstar Petroleum Company
 CONTRACTOR: LEBEN DRILLING, INC.
 FARM: O. P. GILMORE #1
 LOCATION: C SE NW Sec. 3-25S-4W
 RENO COUNTY, KANSAS
 COMMENCED: 11-15-62
 COMPLETED: 12-3-62

0	65	Surface Sand & Clay
65	138	Sand & Shale
138	460	Shale & Shells
460	615	Salt
615	624	Salt & Shale
624	830	Shale & Shells
830	875	Anhydrite
875	895	Shale & Shells
895	1120	Lime & Shale
1120	1285	Lime
1285	1605	Lime & Shale
1605	1855	Shale & Shells
1855	2090	Shale & Shells & Lime
2090	2670	Shale & Lime
2670	2820	Lime & Shale
2820	3250	Lime
3250	3353	Lime & Shale
3353	3500	Mississippi, no chat
3500	3775	Lime & Chert
3775	3947	Shale & Lime
3947	4027	Shale & Sand
4027	4055	Arbuckle
	4055	Rotary Total Depth - D. & A.

FRIEDMAN
 STATE CORPORATION

DEC 26 1962

12-26-62

CONSERVATION DIVISION
 Wichita, Kansas

Set 8 5/8" new surface casing @ 624.90' Cemented with 200 sacks of HA5 by Halliburton.

I, Byron Johnson, do hereby certify that the above and foregoing is a true and correct copy of the log of the O. P. Gilmore #1, located C SE NW of Section 3, Township 25 South, Range 4 West, Reno County, Kansas, as reflected by the files of Leben Drilling, Inc.

Byron Johnson

Byron Johnson

STATE OF KANSAS }
 COUNTY OF BARTON } SS

Subscribed and sworn to before me, a Notary Public, in and for Barton County, Kansas, this 20th day of December, 1962.

Ulanda Nichols

Ulanda Nichols, Notary Public

My Commission Expires:
 April 1, 1963