


STATE OF KANSAS  
STATE CORPORATION COMMISSION

WELL PLUGGING RECORD

Give All Information Completely  
Make Required Affidavit  
Mail or Deliver Report to  
Conservation Division  
State Corporation Comm.  
245 North Water  
Wichita, KS 67202

Edwards County, Sec. 23 Twp. 25S Rge. 17 XX/W  
Location as "NE/CNW $\frac{1}{4}$ SW $\frac{1}{4}$ " or footage from lines  
NW NW NW

Lease Owner Edwards Oil, Inc.  
Lease Name Bogner Well No. 1  
Office Address 1215 E. 30th, Box 206, Hutchinson, Ks.  
Character of Well (Completed as Oil, Gas or Dry Hole) 67501  
Dry Hole

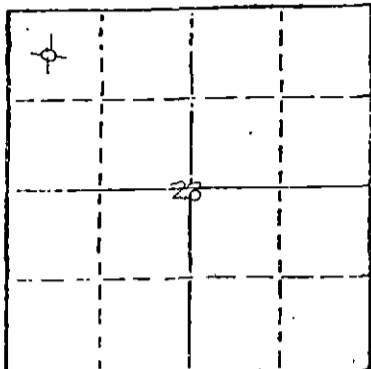

Locate well correctly on above  
Section Plat

Date Well completed October 17, 1981  
Application for plugging filed October 17, 1981  
Application for plugging approved October 17, 1981  
Plugging commenced October 17, 1981  
Plugging completed October 17, 1981  
Reason for abandonment of well or producing formation

If a producing well is abandoned, date of last production 19.

Was permission obtained from the Conservation Division or  
its agents before plugging was commenced? Yes

Name of Conservation Agent who supervised plugging of this well Paul Luphe  
Producing formation Depth to top Bottom Total Depth of Well 4555'  
Show depth and thickness of all water, oil and gas formations.

OIL, GAS OR WATER RECORDS

CASING RECORD

FORMATION	CONTENT	FROM	TO	SIZE	PUT IN	PULLED OUT

Describe in detail the manner in which the well was plugged, indicating where the mud fluid was placed and the method or methods used in introducing it into the hold. If cement or other plugs were used, state the character of same and depth placed, from feet to feet for each plug set.

First Plug @ 950' w. 40 sx  
Second Plug @ 420' w. 35 sx (Wooden Plug)  
Third Plug @ 40' w. 10 sx (Wooden Plug)  
Rathole 5 sx

(If additional description is necessary, use BACK of this sheet)

Name of Plugging Contractor Halliburton

STATE OF KANSAS COUNTY OF RENO, ss.  
Keith D. Smith, operator (employee of owner) or (owner or operator)  
of the above-described well, being first duly sworn on oath, says: That I have knowledge of the facts, statements, and matters herein contained and the log of the above-described well as filed and that the same are true and correct. So help me God.

(Signature)


Box 206, Hutchinson, KS 67501

(Address)

SUBSCRIBED AND SWORN TO before me this 28th day of October, 1981

*Kathy D. Smith*  
Notary Public.

My commission expires April 28, 1984

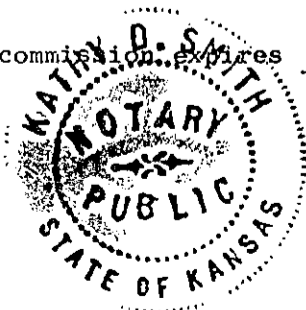

W E L L L O G

15-047-20946-00-00

OPERATOR: Edwards Oil, Inc.

WELL NAME: Bogner # 1 LOCATION: NW NW NW N/2 23-25S-17W

COUNTY: Edwards STATE: Kansas

WELL COMMENCED: 10-8-1981 WELL COMPLETED: 10-17-1981

ELEVATION: 2210' GL TOTAL DEPTH: 4555'

PRODUCTION: D & A RIG NO: 1

CASING - 8 5/8" 10 Jts. of new 8 5/8, # 24, tallied 416', set @ 421'.  
Cemented w. 375 sx of Class A, 3% CC, 2% Gel.

5 1/2" ---

ALL MEASUREMENTS TAKEN FROM THE TOP OF ROTARY BUSHING:

FROM	TO	FORMATION	DEVIATION FROM VERTICAL	REMARKS
0'	134'	Sand		
134'	290'	Sand & Shale		
290'	1495'	Shale		
1495'	2076'	Sand & Shale		
2076'	4455'	Lime & Shale		

RECEIVED  
STATE CORPORATION COMMISSION  
NOV 24 1981  
CONSERVATION DIVISION  
Wichita, Kansas

STATE OF KANSAS  
COUNTY OF Sedgwick  
The undersigned hereby certifies that to the best of his knowledge and belief, the above facts are true and correct.

BIG KAT, INC.  
By [Signature]



SUBSCRIBED AND SWORN TO, BEFORE ME, THIS 23rd day of October 1981

Elfie A. Lacio  
NOTARY PUBLIC  
Elfie A. Lacio

Washdown - Edwards Co.

15-047-20946-00-00

FIELD REPORT

DATE. 8-21-82

OPERATOR. H.F. Johnson

LEASE. Bogner

LOCATION. SEC. 23 . TWP. 25 . RGE. 17

COUNTY. Edwards- SW 1/4

+			

REMARKS. (WHAT WAS SAID OR SEEN).

8 5/8 @ 421' w/ cement Circ.

The well was first drilled Oct. 1981

Re-entry by Santa Fe Reg. Co. 8-21-82

The well was plugged as follows:

0-40' w/ 10sx cement & wooden plug

420' w/ 35sx & wooden Plug

950' w/ 40sx by Halliburton

Broke Circulation at 11:30 AM

Drilled 37' of good cement - no sign of wooden plug - → Starch mud in hole →

2nd plug drilled at 512-544' (sample taken)

3rd plug drilled 891'-1000'

The rat hole w/ 10sx was well plugged.

FOR THE STATE. Steveumont