

15-047-20338-00-00

STATE OF KANSAS


STATE CORPORATION COMMISSION

WELL PLUGGING RECORD

Give All Information Completely  
Make Required Affidavit  
Mail or Deliver Report to  
Conservation Division  
State Corporation Comm.  
245 North Water  
Wichita, KS 67202

Edwards County, Sec. 23 Twp. 25 Rge. 17 E/W  
Location as "NE/CNW $\frac{1}{2}$ SW $\frac{1}{2}$ " or footage from lines  
SW NE

Lease Owner PICKRELL DRILLING COMPANY  
Lease Name BOGNER "A" Well No. 1  
Office Address 205 LITWIN BLDG., WICHITA, KS. 67202  
Character of Well (Completed as Oil, Gas or Dry Hole)  
DRY HOLE

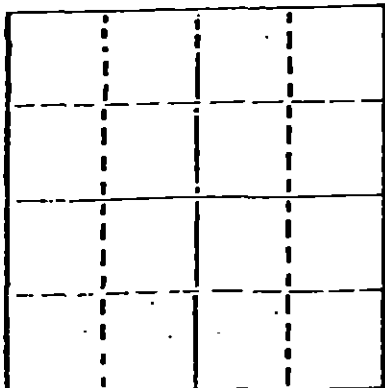

Locate well correctly on above  
Section Plat

Date Well completed 3-05-78 19  
Application for plugging filed 3-05-78 19  
Application for plugging approved 3-05-78 19  
Plugging commenced 3-05-78 19  
Plugging completed 3-05-78 19  
Reason for abandonment of well or producing formation  
Dry Hole

If a producing well is abandoned, date of last production 19

Was permission obtained from the Conservation Division or  
its agents before plugging was commenced? Yes

Name of Conservation Agent who supervised plugging of this well Wm. T. Owen

Producing formation Depth to top Bottom Total Depth of Well 4560

Show depth and thickness of all water, oil and gas formations.

OIL, GAS OR WATER RECORDS

CASING RECORD

FORMATION	CONTENT	FROM	TO	SIZE	PUT IN	PULLED OUT
				8 5/8	262	None

Describe in detail the manner in which the well was plugged, indicating where the mud fluid  
was placed and the method or methods used in introducing it into the hold. If cement or other  
plugs were used, state the character of same and depth placed, from feet to  
feet for each plug-set.

RECEIVED  
STATE CORPORATION COMMISSION

40 sacks at 540'  
35 sacks at 270'  
12 sacks at 40'  
3 sacks in Rat Hole Comp. 6:30PM 2-5-78

MAR 14 1978  
3-14-78  
CONSERVATION DIVISION  
Wichita, Kansas

(If additional description is necessary, use BACK of this sheet)

Name of Plugging Contractor PICKRELL DRILLING COMPANY

STATE OF KANSAS COUNTY OF SEDGWICK, ss.  
C. W. SEBITS (employee of owner) or (owner or operator)

of the above-described well, being first duly sworn on oath, says: That I have knowledge of  
the facts, statements, and matters herein contained and the log of the above-described well  
as filed and that the same are true and correct. So help me God. BY: C. W. SEBITS

(Signature)

205 LITWIN BLDG., WICHITA, KS. 67202

(Address)

SUBSCRIBED AND SWORN TO before me this 10 day of March, 1978

My commission expires

Jo Ann Sarver  
Notary Public.

Jo Ann Sarver



15-047-20338 -00-00  
ROTARY DRILLING LOG

COMPANY: PICKRELL DRILLING COMPANY  
 205 LITWIN BLDG.  
 WICHITA, KS. 67202  
 LOCATION: BOGNER "A" #1  
 SW NE 23-25S-17W  
 EDWARDS CO., KS.  
 CONTRACTOR: PICKRELL DRILLING COMPANY  
 Wichita, Kansas

Rotary Drilling Commenced 2-23-78  
 Rotary Drilling Completed 3-05-78

CASING RECORD: Spud date 2-23-78 Surf. pipe 8 5/8" set at 262' w/225 sacks/

LOG

(Figures indicate bottom of formation — measurements from top of rotary bushing.)

Top Soil	155
Shale	264
Shale & Sand	975
Shale	1550
Shale & Lime	2005
Lime & Shale	2098
Lime & Shale	2265
Lime & Shale	2390
Lime	2436
Shale & Lime	2600
Lime & Shale	2730
Lime & Shale	2920
Lime & Shale	3105
Lime & Shale	3249
Lime	3400
Lime & Shale	3590
Lime & Shale	3727
Lime & Shale	3865
Lime	4010
Lime & Shale	4151
Lime & Shale	4265
Lime	4365
Lime	4450
Lime	4483
Lime	4500
Shale & Sand	4557
Shale & Sand	4560

RECEIVED  
 STATE CORPORATION COMMISSION  
 MAR 14 1978  
 CONSERVATION DIVISION  
 Wichita, Kansas

The undersigned, C. W. SEBITS, Attorney-in-Fact for PICKRELL DRILLING COMPANY, hereby certifies in behalf of said Company, that the above is a true and correct log of the formation encountered in drilling the above well as reflected by the Daily Drilling Reports.

PICKRELL DRILLING COMPANY  
 By [Signature]  
 Attorney-in-Fact  
 Jo Ann Sarver

STATE OF KANSAS }  
 COUNTY OF SEDGWICK } ss.:

On this 10 day of March, 1978, before me the undersigned, a Notary Public, in and for

the County and State aforesaid, personally appeared C. W. Sebitts, to me known to be the identical person who subscribed the name of PICKRELL DRILLING COMPANY to the foregoing instrument as its Attorney-in-Fact and acknowledged to me that he executed the same as his free and voluntary act and deed, and as the free and voluntary act and deed of such company, for the uses and purposes therein set forth.

Given under my hand and seal of office the day and year last above written.

My commission expires: \_\_\_\_\_

[Signature]  
 Notary Public  
 Jo Ann Sarver

