

STATE OF KANSAS
STATE CORPORATION COMMISSION

WELL PLUGGING RECORD

Give All Information Completely
Make Required Affidavit


Mail or Deliver Report to:
Conservation Division
State Corporation Commission
800 Bittling Building
Wichita, Kansas

FORMATION PLUGGING RECORD

Strike out upper line
when reporting plug-
ging off formations.

OR

Edwards County. Sec. 22 Twp 25S Rge. ~~17~~ 17 (W)
Location as "NE $\frac{1}{4}$ NW $\frac{1}{4}$ SW $\frac{1}{4}$ " or footage from lines C. SW/4, SW/4
Lease Owner Stanolind Oil & Gas Co. - Wilcox Oil Company
Lease Name L. McCarty Well No. 1
Office Address Box 591, Tulsa 2, Oklahoma
Character of Well (completed as Oil, Gas or Dry Hole) Gas
Date well completed 6/30 19 30
Application for plugging filed. Phone Letter 9/6 19 45
Application for plugging approved. Phone Letter 9/10 19 45
Plugging commenced September 9 19 45
Plugging completed September 16 19 45
Reason for abandonment of well or producing formation No. longer producing

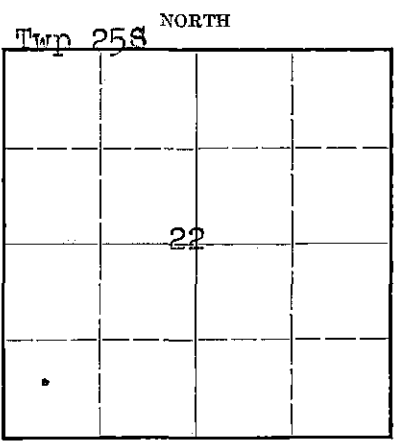

R
g
e
l
7
W

Locate well correctly on above
Section Plat

If a producing well is abandoned, date of last production December 19 44
Was permission obtained from the Conservation Division or its agents before plugging was com-
menced? Yes

Name of Conservation Agent who supervised plugging of this well Mr. H. W. Kerr
Producing formation Sooy Sand Depth to top 4450' Bottom 4469' Total Depth of Well 4960 Feet
Show depth and thickness of all water, oil and gas formations. Pluggd Back - 4575'

OIL, GAS OR WATER RECORDS


CASING RECORD

Formation	Content	From	To	Size	Put In	Pulled Out
Sooy Sand	Gas & Water	4450	4469	24"	147'	None
				8-5/8"	4334'	2532'
				6-5/8"	4592'	Prev. Pulled 4300'

Describe in detail the manner in which the well was plugged, indicating where the mud fluid was placed and the method or methods used in introducing it into the hold. If cement or other plugs were used, state the character of same and depth placed, from _____ feet to _____ feet for each plug set.

Filled with mud from 4575' to 4445' then ran 7 sacks cement, plugged from 4445' to 4410', then filled with mud to 200' and ran 45 sacks cement -plugged from 200' to 180', then filled with mud to 20' and capped to cellar base with 25 sacks cement.

PLUGGING
FILE 22 25 17W
BOOK PAGE 25 LINE 19

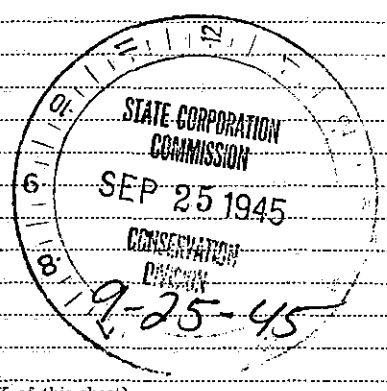

(If additional description is necessary, use BACK of this sheet)

Correspondence regarding this well should be addressed to Mr. C. B. Snyder
Address P.O. Box 518, Zenith, Kansas


STATE OF Kansas, COUNTY OF Stafford, ss.
Mr. C. B. Snyder (employee of owner) or (owner or operator) of the above-described well,
being first duly sworn on oath, says: That I have knowledge of the facts, statements, and matters herein contained and the log of the above-described well as filed and that the same are true and correct. So help me God.

(Signature) C. B. Snyder
Zenith, Kansas (Address)

SUBSCRIBED AND SWORN to before me this 24 day of September 19 45
My Commission Expires Dec. 20, 1947
W. C. Johnson Notary Public

McCARTY, J. L., WELL #1,
SW 1/4 Sec. 22-T25S-R17W
Edwards County, Kansas

Top	BOTTOM	FORMATION	Top	BOTTOM	FORMATION
0	65	Quick Sand	2555	2560	Red Rock
65	101	Yellow Sand & Clay	2560	2590	White Lime
101	135	Yellow Clay	2590	2625	Red Shale
135	147	Sandy Clay	2625	2640	White Lime
147	175	Yellow Clay	2640	2698	Blue Slate
175	220	Blue Mud, H. F. W.	2698	2710	Red Rock
220	375	Blue Mud	2710	2735	White Lime
375	385	Sand	2735	2740	Blue Slate
385	430	Light Shale	2740	2745	Red Rock
430	480	White Sand, H. F. W.	2745	2765	White Lime
485	495	Red Rock	2765	2770	Red Rock & Blue Shale
495	510	Gray Lime	2770	2828	White Lime
510	590	Red Rock	2828	2850	Gray Lime
590	595	Blue Shale	2850	2860	Red Rock
595	648	Red Rock	2860	2897	White Lime
648	660	Gypsy Lime	2897	2907	Blue Slate
660	710	Gypsy Shells & Red Rock	2907	2917	Gray Lime
710	990	Red Rock	2917	2924	Blue Slate
990	992	Gypsy Shells	2924	2961	White Sandy Lime, 5 B. W.
992	1040	Red Shale	2961	2981	Gray Lime
1040	1050	Red Sand, 5 B. W.	2981	3010	Gray Sandy Lime H. F. W.
1050	1140	Red Shale	3010	3028	Blue Shale
1140	1165	White Lime	3028	3047	Gray Lime
1165	1195	Red Rock	3047	3052	Blue Shale
1195	1268	Red Shale	3052	3080	Gray Lime
1268	1430	Red Rock	3080	3100	Black Slate
1430	1450	Red Rock, Blue Slate	3100	3114	Broken Lime
1450	1470	Red Rock, Gypsy Shells	3114	3120	Blue Slate
1470	1515	Blue Slate	3120	3125	Red Slate
1515	1539	Shale, Blue Shale, Red Rock, Hole Caving	3125	3135	Gray Lime
1539	1545	Broken Lime	3135	3220	Blue Shale
1545	1625	Blue Slate	3220	3239	Broken Lime
1625	1665	Brown Shale & Gypsy Shell	3239	3245	Gray Lime
1665	1670	Salt & Blue Shale	3245	3307	Blue Slate
1670	1710	Blue Slate	3307	3327	Blue Slate & Lime Shells
1710	1815	Blue Shale & Salt	3327	3430	Gray Lime 2 B. W. 3375
1815	1875	Salt & Gypsy Shell	3430	3440	Blue Slate
1875	1965	Blue Shale & Salt	3440	3480	Gray Lime
1965	2010	Salt	3480	3645	Gray Lime 5 B. W. & More
2010	2030	Blue Shale & Salt.	3645	3650	Blue Slate
2030	2100	Salt	3650	3700	White Lime
2100	2120	Gray Lime	3700	3707	Black Slate
2120	2195	Blue Shale & Gypsy Shell	3707	3740	White Lime
2195	2205	Gray Lime	3740	3743	Black Slate
2205	2210	Gray Blue Slate	3743	3750	Black Slate
2210	2220	Gray Lime	3750	3810	Gray Lime
2220	2230	Blue Slate	3810	3815	Black Slate
2230	2260	White Lime	3815	3840	Gray Lime
2260	2270	Red Shale	3840	3848	Blue Slate
2270	2303	Gray Lime	3848	3853	Gray Lime
2303	2325	Gray Sandy Lime - Show of Gas & Little Water	3853	3868	Blue Slate
2325	2334	Blue Shale	3868	3883	White Lime
2334	2363	Gray Lime 132,000' Gas	3883	3923	Blue Slate (Muddy) 3000' W.
2363	2380	Blue Slate	3923	3934	Blue Slate
2380	2390	Red Shale	3934	3993	Blue Slate
2390	2500	Gray Lime	3993	3998	White Lime
2500	2550	Gray Sandy Lime	3998	4001	Blue Slate
2550	2555	Blue Slate	4001	4033	White Lime
			4033	4035	White Lime
			4035	4038	White Lime
			4038	4042	Blue Shale

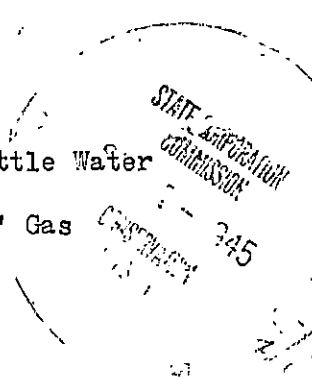

PLACING
FILE 22 25 R 17 W
BOOK PAGE 25 LINE 19

<u>TOP</u>	<u>BOTTOM</u>	<u>FORMATION</u>
4042	4065	Gray Lime
4065	4148	White Lime
4148	4155	Blue Shale
4155	4206	White Lime
4206	4222	Blue Shale
4222	4252	White Lime
4252	4262	Blue Shale
4262	4290	White Lime
4290	4298	Blue Shale
4298	4331	Gray Lime
4331	4362	Blue Shale
4362	4380	Blue Shale & Shells
4380	4390	Red Shale and Shells
4390	4400	Gray Lime
4400	4410	Red and Blue Shale
4410	4432	Broken Lime
4432	4450	White Slate
4450	4452	White Lime Shows Gas
4452	4467	Gray Sandy Lime 10 M Ga s 1264#
4467	4492	Broken Lime Top Chat
4492	4532	Hard, Sharp, Gray Lime
4532	4535	Red Rock
4535	4552	Varigated Shales
4552	4592	Detrital - Red, White Green Shale Shells
4592		Top Gray Sandy Lime - 2 B. W.
4592	4667	Gray Sandy Lime
4667		Gray Sandy Lime H. F. W.
4667	4716	Gray Sandy Lime
4716	4819	White Lime
4819	4833	White Lime H. F. Sulphur W.
4833	4853	Blue Shale
4853	4874	White Sandy Lime
4874	4894	Green Shale
4894	4941	White Lime
4941	4944	Green Shale
4944	4960	White Lime H. F. S. W.

PLUGGING
 FILE 22 25 (17.11)
 BOOK PAGE 25 LINE 19

