


STATE OF KANSAS
STATE CORPORATION COMMISSION

WELL PLUGGING RECORD

Give All Information Completely
Make Required Affidavit
Mail or Deliver Report to
Conservation Division
State Corporation Comm.
245 North Water
Wichita, KS 67202

Edwards County, Sec. 22 Twp. 25S Rge. 17W E/W
Location as "NE/CNW $\frac{1}{4}$ SW $\frac{1}{4}$ " or footage from lines _____

C SW NW
Lease Owner Big J Production
Lease Name Fisher Well No. 1
Office Address P. O. Box 11245 729 E. Central Wichita, Kansas
Character of Well (Completed as Oil, Gas or Dry Hole) Dry Hole

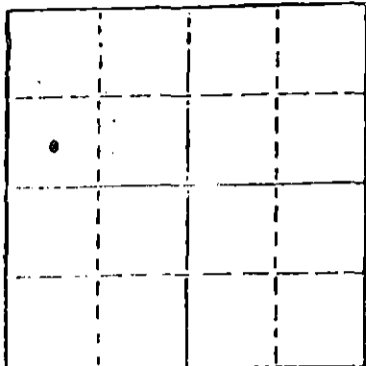

Locate well correctly on above
Section Plat

Date Well completed 4-10-80 19
Application for plugging filed 4-10-80 19
Application for plugging approved 4-10-80 19
Plugging commenced 4-10-80 19
Plugging completed 4-10-80 19
Reason for abandonment of well or producing formation _____

If a producing well is abandoned, date of last production 19 _____

Was permission obtained from the Conservation Division or its agents before plugging was commenced? Yes _____

Name of Conservation Agent who supervised plugging of this well Wm. T. Owen
Producing formation _____ Depth to top _____ Bottom _____ Total Depth of Well 4670'
Show depth and thickness of all water, oil and gas formations.

OIL, GAS OR WATER RECORDS

CASING RECORD:


FORMATION	CONTENT	FROM	TO	SIZE	PUT IN	PULLED OUT

Describe in detail the manner in which the well was plugged, indicating where the mud fluid was placed and the method or methods used in introducing it into the hold. If cement or other plugs were used, state the character of same and depth placed, from _____ feet to _____ feet for each plug set.

Mud To 600' 50 Sacks 50-50 Posmix
Mud To 360' 40 Sacks 50-50 Posmix
Mud To 40' 10 Sacks 50-50 Posmix
Rat Hole 5 Sacks 50-50 Posmix
Mouse Hole 3 Sacks 50-50 Posmix

(If additional description is necessary, use BACK of this sheet)

Name of Plugging Contractor Merckle Drilling Co

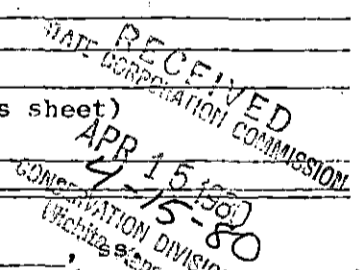

STATE OF Kansas COUNTY OF Barton
Clyde Merckle (employee of owner) or (owner/operator)

of the above-described well, being first duly sworn on oath, says: That I have knowledge of the facts, statements, and matters herein contained and the log of the above-described well as filed and that the same are true and correct. So help me God.

(Signature) Clyde Merckle
P. O. Box 1382 Great Bend, Kansas 67530

SUBSCRIBED AND SWORN TO before me this 14th day of April, 1980

Louisa Lamy Notary Public.

My commission expires 3-28-84



Big J Production
P. O. Box 11245 729 E. Central
Wichita, Kansas 67202

Fisher #1

C SW NW Section 22 Twp 25S Rge 17W

Edwards County

Driller's Log-----Total Depth 4670'

0---=---210 Sand

210----364 Blue Shale

364----385 Blue Shale

385----520 Sand

520----1275 Red Bed & Shale

1275---2080 Shale & Lime Shells

2080---3015 Lime & Shale

3015---3200 Lime & Shale

3200---3590 Lime & Shale

3590---4095 Lime & Shale

4095---4545 Lime

4545---4670 Lime


Clyde Merckle

RECEIVED
OIL & GAS PATROL COMMISSION
APR 15 1980
CONSERVATION DIVISION
Wichita, Kansas