

STATE OF KANSAS
STATE CORPORATION COMMISSION


WELL PLUGGING RECORD

Get All Information Completely
Make Required Affidavit
Mail or Deliver Report to:
Conservation Division
State Corporation Commission
211 No. Broadway
Wichita, Kansas

Edwards County. Sec. 34 Twp. 25 Rge. 17 (E) W (W)

Location as "NE/CNW/SW" or footage from lines. NE NE NW
Lease Owner Braden Drilling, Inc.
Lease Name Getterman Well No. 1
Office Address Wichita, Kansas
Character of Well (completed as Oil, Gas or Dry Hole)
Date well completed 19
Application for plugging filed 19
Application for plugging approved 19
Plugging commenced 7-12-62 19
Plugging completed 7-17-62 19
Reason for abandonment of well or producing formation Depleted.

NORTH

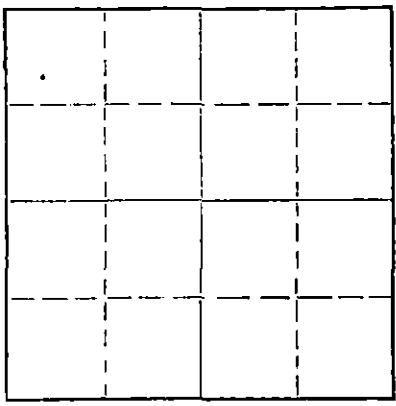

Locate well correctly on above
Section Plat

If a producing well is abandoned, date of last production 19
Was permission obtained from the Conservation Division or its agents before plugging was commenced? yes

Name of Conservation Agent who supervised plugging of this well Justice
Producing formation Depth to top Bottom Total Depth of Well 4670 Feet
Show depth and thickness of all water, oil and gas formations.

OIL, GAS OR WATER RECORDS

CASING RECORD

FORMATION	CONTENT	FROM	TO	SIZE	PUT IN	PULLED OUT
				8-5/8"	277'	None
				5-1/2"	4548'	2579'

Describe in detail the manner in which the well was plugged, indicating where the mud fluid was placed and the method or methods used in introducing it into the hole. If cement or other plugs were used, state the character of same and depth placed, from feet to feet for each plug set.

Checked hole to 4500', ran 50 gal. of sand to 4450' and dumped 5 sacks of cement @ 4450' with dump bailer. Pulled 5 1/2" casing, bailed hole from 80' to 250', set rock bridge to 240' and ran 20 sacks of cement @ 240'. Mudded to 35', set rock bridge to 30' and ran 10 sacks of cement to base of cellar.

PLUGGING COMPLETE.

RECEIVED
STATE CORPORATION COMMISSION
JUL 25 1962
RECEIVED
STATE CORPORATION COMMISSION
CONSERVATION DIVISION JUL 25-62
Wichita, Kansas
CONSERVATION DIVISION
Wichita, Kansas

Name of Plugging Contractor KNIGHT CASING PULLING COMPANY
Address CHASE, KANSAS

STATE OF KANSAS, COUNTY OF RICE, ss.
Noel J. Knight (employee of owner) or (owner/operator) of the above-described well, being first duly sworn on oath, says: That I have knowledge of the facts, statements, and matters herein contained and the log of the above-described well as filed and that the same are true and correct. So help me God.

(Signature) Noel J. Knight
Chase, Kansas
(Address)

SUBSCRIBED AND SWORN TO before me this 21st day of July, 1962

Milton J. Volin
Notary Public.

My commission expires May 20, 1964

