


STATE OF KANSAS  
STATE CORPORATION COMMISSION

WELL PLUGGING RECORD

Give All Information Completely  
Make Required Affidavit  
Mail or Deliver Report to:  
Conservation Division  
State Corporation Commission  
212 North Market, Insurance Bldg.  
Wichita, Kansas

NORTH

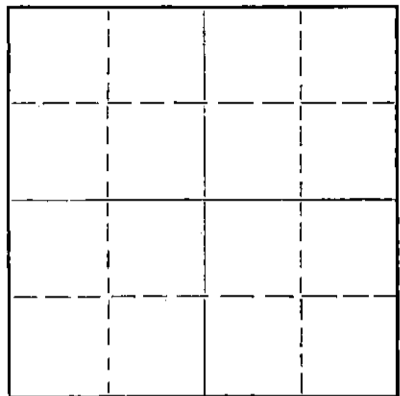

Locate well correctly on above  
Section Plat

Edwards County, Sec. 36 Twp. 25 Rge. 17 (E) W. (W)  
Location as "NE/CNW/SW" or footage from lines 660' N. & 660' W. of E/4 Cor.  
Lease Owner Cities Service Oil Company  
Lease Name Campbell "C" Well No. 1  
Office Address Box 144, Great Bend, Kansas  
Character of Well (completed as Oil, Gas or Dry Hole) Dry Hole  
Date well completed September 29 19 59  
Application for plugging filed September 30 19 59  
Application for plugging approved September 30 19 59  
Plugging commenced September 30 19 59  
Plugging completed September 30 19 59  
Reason for abandonment of well or producing formation Dry Hole

If a producing well is abandoned, date of last production - 19-  
Was permission obtained from the Conservation Division or its agents before plugging was commenced? Yes

Name of Conservation Agent who supervised plugging of this well Frank Broadfoot  
Producing formation None Depth to top - Bottom - Total Depth of Well 4620 Feet  
Show depth and thickness of all water, oil and gas formations.

OIL, GAS OR WATER RECORDS

CASING RECORD

FORMATION	CONTENT	FROM	TO	SIZE	PUT IN	PULLED OUT
				8-5/8"	426'	None

Describe in detail the manner in which the well was plugged, indicating where the mud fluid was placed and the method or methods used in introducing it into the hole. If cement or other plugs were used, state the character of same and depth placed, from \_\_\_\_\_ feet to \_\_\_\_\_ feet for each plug set.

4620-300', heavy mud.  
300-240', wood plug, 5 sacks hulls and 20 sacks cement.  
240- 35', heavy mud.  
35' to base of cellar, wood plug, hulls and 10 sacks cement.

**RECEIVED**  
STATE CORPORATION COMMISSION  
OCT 22 1959  
10-22-59  
CONSERVATION DIVISION  
Wichita, Kansas

(If additional description is necessary, use BACK of this sheet)

Name of Plugging Contractor Barbour Drilling Company  
Address Tulsa, Oklahoma

STATE OF Kansas COUNTY OF Barton, ss.  
John D. Forsyth (employee of owner) ~~OR (owner or operator)~~ of the above-described well, being first duly sworn on oath, says: That I have knowledge of the facts, statements, and matters herein contained and the log of the above-described well as filed and that the same are true and correct. So help me God.

(Signature) John D. Forsyth  
Box 144, Great Bend, Kansas  
(Address)

SUBSCRIBED AND SWORN TO before me this 12th day of October, 19 59

My commission expires March 12, 1963.

W. D. Smith  
Notary Public.

WELL RECORD

RECEIVED  
STATE CORPORATION COMMISSION  
OCT 22 1959  
CONSERVATION DIVISION  
Wichita, Kansas

WILDCAT.....

DISCOVERY.....

POOL.....

COMPANY Cities Service Oil Company WELL # 1 FARM Campbell

LOCATION 660' North and 660' West of E/4 Corner

Section 36, Township 25, Range 17W

ELEV. 2100 (2097 Gr.) CO. Edwards STATE Kansas

IP. Dry hole.

PERFS.....

FRAC..... ACID None

T.D. 4620' PBDT..... GRAV/GOR.....

DRLG. COMM. Sept. 7, 1959 COMP. Sept. 30, 1959 CONTRACTOR Barbour Drilling Company

CASING RECORD:

8-5/8" at 368' with 250 sacks cement.

FORMATION RECORD:

clay and sand	0-45
shale and shells	420
sand and shale	490
red bed and shale	1125
Anhydrite	1140
shale and shells	1995
lime and shale	2190
lime	2415
lime and shale	2535
shale	2645
shale and lime	2875
shale	3400
shale and lime	3490
lime and shale	3595
shale and lime	3675
lime and shale	3925
shale and lime	3975
lime	4385
lime and sand	4400
Cored lime and shale (rec. 27 1/2')	4427 1/2
lime	4470
Cored shale & Conglomerate (rec. 23')	4493
Cored shale and chert (rec. 5 1/2')	4500
Cored chert (rec. 11')	4511
Cored chert and shale (rec. 15')	4526
chert	4536
cherty lime	4540
lime and shale	4555
shale	4570

sand	4587
sand and shale	4600
chert	4620 T.D.
Hebner	3810
Brown Limestone	3958
Lansing	3971
Base Kansas City	4277
Cherokee Shale	4419
Conglomerate	4475
Kinderhook	4537
Viola	4600
Pen.	20'
T.D.	4620

D.S.T. 4466-93, open 1 hr., rec. 77' mud;  
B.H.P. 420# in 30 minutes.  
D.S.T. 4485-4500, open 1 hr., rec. 60' mud;  
B.H.P. 870# in 30 minutes.  
D.S.T. 4500-4511, open 1 hr., rec. 82'  
gassy oil spotted mud; B.H.P. 220# in  
30 minutes.  
D.S.T. 4524-36, open 1 hr., rec. 29' mud;  
B.H.P. 135# in 30 minutes.

Slope Tests (Totco):

160'	- 1/2°
500'	- 1 1/2°
1000'	- 1 1/2°
1500'	- 1°
2000'	- 1 1/2°
2265'	- 1°
2510'	- 1 1/2°
2985'	- 2°
3468'	- 2°
3679'	- 2°
4010'	- 2 1/2°