


Give All Information Completely  
Make Required Affidavit  
Mail or Deliver Report to:  
Conservation Division  
State Corporation Commission  
211 No. Broadway  
Wichita, Kansas

WELL PLUGGING RECORD

Edwards County. Sec. 25 Twp. 25S Rge. 19W (E)(W)  
Location as "NE/CNW/SW" or footage from lines C SE NE  
Lease Owner Tom Palmer Estate  
Lease Name Adams Well No. 1  
Office Address 1330 Wichita Plaza, Wichita, Kansas  
Character of Well (completed as Oil, Gas or Dry Hole) Dry Hole  
Date well completed September 10, 1966  
Application for plugging filed September 10, 1966  
Application for plugging approved September 10, 1966  
Plugging commenced September 10, 1966  
Plugging completed September 10, 1966  
Reason for abandonment of well or producing formation Dry Hole

NORTH

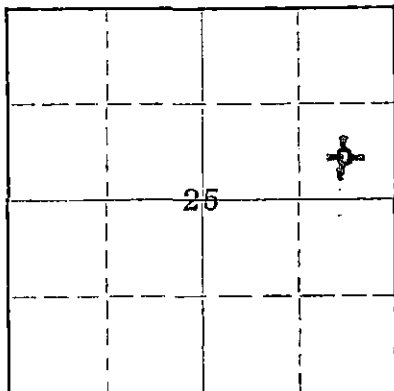

Locate well correctly on above  
Section Plat

If a producing well is abandoned, date of last production \_\_\_\_\_ 19\_\_\_\_  
Was permission obtained from the Conservation Division or its agents before plugging was commenced? Yes

Name of Conservation Agent who supervised plugging of this well Herman Justus  
Producing formation \_\_\_\_\_ Depth to top \_\_\_\_\_ Bottom \_\_\_\_\_ Total Depth of Well 4745 Feet  
Show depth and thickness of all water, oil and gas formations.

OIL, GAS OR WATER RECORDS

CASING RECORD

FORMATION	CONTENT	FROM	TO	SIZE	PUT IN	PULLED OUT
		0'	245'	8-5/8"	245'	None

Describe in detail the manner in which the well was plugged, indicating where the mud fluid was placed and the method or methods used in introducing it into the hole. If cement or other plugs were used, state the character of same and depth placed, from \_\_\_\_\_ feet to \_\_\_\_\_ feet for each plug set.

4745'-200' Mud  
200'-196' Plug  
196'-156' Cement, 25 sacks  
156'-40' Mud  
40'-36' Plug  
36'-6' Cement, 10 sacks (bottom of cellar)

RECEIVED  
STATE CORPORATION COMMISSION

SEP 16 1966  
9-16-66  
CONSERVATION DIVISION  
Wichita, Kansas

(If additional description is necessary, use BACK of this sheet)

Name of Plugging Contractor Globe Cementing Co.  
Address Great Bend, Kansas

STATE OF KANSAS, COUNTY OF SEDGWICK, ss.  
John H. Knightley (employee of owner) or (owner or operator) of the above-described well, being first duly sworn on oath, says: That I have knowledge of the facts, statements, and matters herein contained and the log of the above-described well as filed and that the same are true and correct. (So help me God.)

(Signature) John H. Knightley  
301 S. Broadway, Wichita, Kansas  
(Address)

SUBSCRIBED AND SWORN TO before me this 14th day of September, 19 66

My commission expires March 12, 1967

Stella J. Lippis  
Notary Public.

Tom Palmer Estate

Adams #1

C SE NE Sec. 25-25S-19W  
Edwards County, Kansas

Commenced: August 26, 1966;  
Completed: September 10, 1966.

Rotary Drilling Contractor: Lauck Drilling Company, Incorporated

Casing Record: 245' 8-5/8" Cemented with 210 sacks Cement,  
4 sacks Calcium Chloride.

Elevation: GR 2194; DF 2197; KB 2199.

Drillers Log

Sand	105
Sand & shale	125
Red Bed	160
Shale	540
Sand & red bed	695
Red Bed	1150
Shale	1276
Anhydrite	1313
Shale	1347
Shale & shells	2222
Lime	2250
Lime & shale	2440
Lime with shale streaks	2542
Lime & shale	2745
Lime with shale streaks	2850
Lime & shale	3025
Lime	3125
Lime & shale	3430
Shale & lime	3612
Lime & shale	3755
Lime	3980
Lime & shale	4065
Shale & lime	4100
Lime	4420
Lime & shale	4475
Lime	4659
Shale, sandy	4670
Mississippian	4690
Chert	4710
Chert, sand & shale	4745 RTD

RECEIVED  
STATE CORPORATION COMMISSION

SEP 16 1966

CONSERVATION DIVISION  
Wichita, Kansas