


WELL PLUGGING RECORD

Give All Information Completely
Make Required Affidavit
Mail or Deliver Report to:
Conservation Division
State Corporation Commission
212 No. Market
Wichita, Kansas

Edwards County, Sec. 8 Twp. 25S Rge. ~~XX~~ 20 (W)
Location as "NE/CNW/SW" or footage from lines C SW SW
Lease Owner Pickrell Drilling Company
Lease Name Butler 'B' Well No. 2
Office Address 705 Fourth National Bank Bldg., Wichita, Kansas
Character of Well (completed as Oil, Gas or Dry Hole) Dry Hole
Date well completed December 12 19 69
Application for plugging filed December 12 19 69
Application for plugging approved December 12 19 69
Plugging commenced December 12 19 69
Plugging completed December 12 19 69
Reason for abandonment of well or producing formation Dry Hole

NORTH

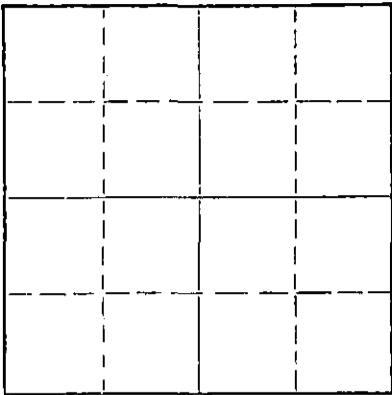

Locate well correctly on above
Section Plat

If a producing well is abandoned, date of last production _____ 19____
Was permission obtained from the Conservation Division or its agents before plugging was commenced? Yes

Name of Conservation Agent who supervised plugging of this well Herman Justus
Producing formation _____ Depth to top _____ Bottom _____ Total Depth of Well 4215 Feet
Show depth and thickness of all water, oil and gas formations.

OIL, GAS OR WATER RECORDS

CASING RECORD

FORMATION	CONTENT	FROM	TO	SIZE	PUT IN	PULLED OUT
				320'	8-5/8"	None

Describe in detail the manner in which the well was plugged, indicating where the mud fluid was placed and the method or methods used in introducing it into the hole. If cement or other plugs were used, state the character of same and depth placed, from _____ feet to _____ feet for each plug set.

Plug @ 450' w/50 sacks, plug @ 300' w/25 sacks
and plug @ 40' w/10 sacks.

RECEIVED
STATE CORPORATION COMMISSION
JAN 7 1970
CONSERVATION DIVISION
Wichita, Kansas
1-7-70

(If additional description is necessary, use BACK of this sheet)

Name of Plugging Contractor Pickrell Drilling Company
Address 705 Fourth National Bank Bldg., Wichita, Kansas 67202

STATE OF Kansas COUNTY OF Sedgwick, ss.
C. W. Sebitts

(employee of owner) or (owner or operator) of the above-described well, being first duly sworn on oath, says: That I have knowledge of the facts, statements and matters herein contained and the log of the above-described well as filed and that the same are true and correct. So help me God.

(Signature) C. W. Sebitts
705 Fourth National Bank Bldg., Wichita, Kansas
(Address)

Subscribed and Sworn to before me this 17th day of December, 19 69



L. M. Whiting
L. M. Whiting Notary Public.

My commission expires May 10, 1970

ROTARY DRILLING LOG

COMPANY: Pickrell Drilling Company
705 Fourth National Bank Bldg.
Wichita, Kansas

Rotary Drilling Commenced 12/4/69

Rotary Drilling Completed 12/12/69

LOCATION: Butler "B" No. 2 @ SW SW Sec. 8-25S-20W
Edwards County, Kansas

CONTRACTOR: PICKRELL DRILLING COMPANY
Wichita, Kansas

CASING RECORD: Run 15 Jts. 28# 8-5/8" surface casing set @ 320' KB. Cemented with 200 sacks. Completed 6:00 PM December 4, 1969. Circulated.

No oil string run. D & A. Plugged 8:30 PM December 12, 1969.

LOG

(Figures indicate bottom of formation — measurements from top of rotary bushing.)


40	Top Soil - Clay		<u>C.F.S.</u>
320	Shale & Sand Streaks		4130
485	Shale		4155
840	Sand & Shale		4215
1000	Red Beds - Shale		
1050	Sand		
1400	Red Beds - Shale		
1404	Shale		<u>S.L.M.</u>
1425	Anhydrite	Board	3795.33
1830	Shale & Shells w/Lime Streaks	Strap	<u>3794.50</u>
2270	Shale & Lime Streaks		.83 Difference
2355	Lime - Shale		
2875	Lime		
3255	Lime & Shale		<u>Slope Tests</u>
3470	Shale & Lime		2000
3625	Lime & Shale		2500
3795	Shale & Lime		3000
3900	Lime & Shale		3500
4005	Lime		4000
4095	Lime & Shale		
4215	Lime, RTD		

RECEIVED
STATE CORPORATION COMMISSION
JAN 7 1970
CONSERVATION DIVISION
Wichita, Kansas

The undersigned, C. W. Sebitts, Attorney-in-Fact for PICKRELL DRILLING COMPANY, hereby certifies in behalf of said Company, that the above is a true and correct log of the formation encountered in drilling the above well as reflected by the Daily Drilling Reports.

PICKRELL DRILLING COMPANY

By [Signature]
C. W. Sebitts Attorney-in-Fact

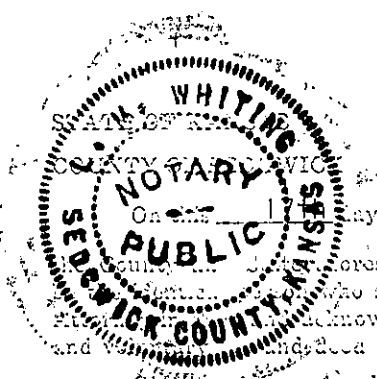

ss.:

On this day of December, 19 69, before me the undersigned, a Notary Public, in and for

Edwards County, Kansas, the undersigned, personally appeared C. W. Sebitts, to me known to be the person who subscribed the name of PICKRELL DRILLING COMPANY to the foregoing instrument, and he acknowledged to me that he executed the same as his free and voluntary act and deed, and that he is an authorized officer and agent of such company, for the uses and purposes therein set forth.

Given under my hand and seal of office the day and year last above written.

My commission expires: May 10, 1970

[Signature]
L. M. Whiting Notary Public