

STATE OF KANSAS
STATE CORPORATION COMMISSION


WELL PLUGGING RECORD

Give All Information Completely
Make Required Affidavit
Mail or Deliver Report to:
Conservation Division
State Corporation Commission
800 Bitting Building
Wichita, Kansas

OR
FORMATION PLUGGING RECORD

Strike out upper line
when reporting plugging
of formations.

NORTH

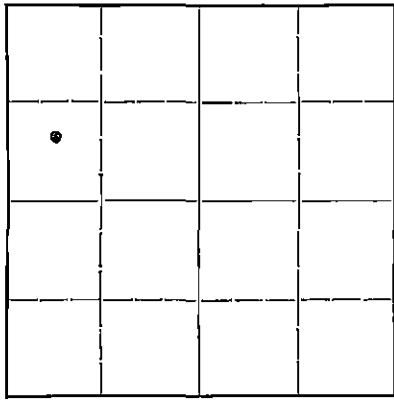

Locate well correctly on above
Section Plat

Reno County. Sec. 18 Twp. 24 Rge. (E) 10 (W)
Location as "NE 1/4 NW 1/4 SW 1/4" or footage from lines Cen. N/2 SW/4 NW/4
Lease Owner Cities Service Oil Company
Lease Name Kanatzar Well No. 1
Office Address Bartlesville, Oklahoma
Character of Well (completed as Oil, Gas or Dry Hole) Dry Hole
Date, well completed October 16, 1941
Application for plugging filed October 16, 1941
Application for plugging approved October 16, 1941
Plugging Commenced October 16, 1941
Plugging Completed October 16, 1941
Reason for abandonment of well or producing formation Dry Hole

If a producing well is abandoned, date of last production 19
Was permission obtained from the Conservation Division or its agents before plugging was commenced? Yes

Name of Conservation Agent who supervised plugging of this well Ruel Durkee
Producing formation None Depth to top Bottom Total Depth of Well 3842 Feet
Show depth and thickness of all water, oil and gas formations.

OIL, GAS OR WATER RECORDS


CASING RECORD

Formation	Content	From	To	Size	Put In	Pulled Out
Topeka Lime	Dry	3000	3328	10-3/4"	262'	None
Kansas City Lime	Dry	3538	3733			
Viola Lime	Dry	3800	3842			

Describe in detail the manner in which the well was plugged, indicating where the mud fluid was placed and the method or methods used in introducing it into the hole. If cement or other plugs were used, state the character of same and depth placed, from feet to feet for each plug set.

Filled hole with mud from 3842' to bottom of 10-3/4" O. D. casing at 262'. Set bridge and dumped 10 sacks cement. Filled hole with mud to 5' of top 10-3/4" O. D. casing. Dumped 5 sacks cement from 5' to surface. Welded cap over top of 10-3/4" O. D. casing.

PLUGGING
FILE 18-24-10W
BOOK 11 PAGE 41

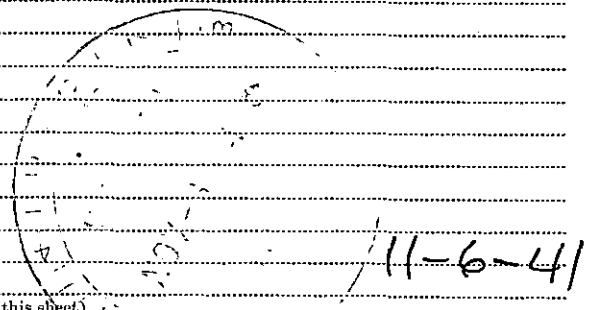

Correspondence regarding this well should be addressed to R. C. Hauber
Address Cities Service Oil Co., Great Bend, Kansas

STATE OF Kansas, COUNTY OF Barton, ss.
C. J. Kerwin (employee of owner) of the above-described well,

being first duly sworn on oath, says: That I have knowledge of the facts, statements, and matters herein contained and the log of the above-described well as filed and that the same are true and correct. So help me God.

(Signature) C. J. Kerwin
Great Bend, Kansas (Address)

SUBSCRIBED AND SWORN to before me this 27 day of October, 1941

(Signature) Notary Public

My commission expires My Commission Expires Sept. 26, 1942

WELL RECORD

Company Cities Service Oil Co. Well No. 1 Farm Kanatzar
 Location 990' north & 660' east of N/4 Corner Sec. 18 T. 24 R. 10-W
 Elevation 1788 County Reno State Kansas
 Drig. Comm. September 29, 1941 Contractor Corbett-Barbour Drilling Company
 Drig. Comp. October 16, 1941 Acid None
 T.D. 3842' Initial Prod. Dry - Plugged and Abandoned

CASING RECORD:

10-3/4" @ 262' con. 150 sx Red
 Wing & 200# C. C.


Top Lansing 3371
 Top Misener 3802
 Top Viola 3807
 Penetration 35'
 Total Depth 3842

FORMATION RECORD:

surface 0-40
 sand 160
 red bed 500
 shale & gypsum 770
 shale & shells 1050
 salt 1330
 shale & shells 1400
 anhydrite 1445
 broken lime 1780
 sandy lime 1865
 lime 1942
 lime broken 2066
 broken lime & shale 2142
 shale & shells 2277
 broken lime 2359
 shale & shells 2625
 shale 2744
 lime 2788
 shale & lime 2925
 broken lime 2945
 lime 3228
 shale & shells 3338
 shale 3345
 lime & shale 3381
 lime 3421
 lime & chert 3476
 lime 3733
 conglomerate 3767
 cored shale (rec. 12') 3780
 shale 3802
 cored sand, chert & lime 3802-3812 (rec. 6')
 lime 3842 T. D.

Oct. 14, 1941 - Halliburton
 drill stem test, 3802-12, made
 80' water with trace oil in 20
 minutes; bottom hole pressure
 900 lbs.

Syfo: 500' 00
 1000' 00
 1500' 00
 2000' 00
 3000' 00
 3500' 00

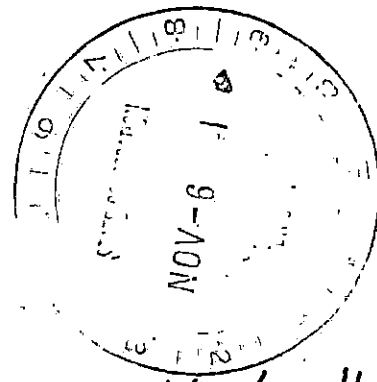

DRILLING
 FILE 18-24-204
 BOOK 11-41

11-6-41