

15-155-01993-0000

STATE OF KANSAS
STATE CORPORATION COMMISSION


WELL PLUGGING RECORD
OR
FORMATION PLUGGING RECORD

Strike out upper line
when reporting plug-
ging off formations.

Give All Information Completely
Make Required Affidavit
Mail or Deliver Report to:
Conservation Division
State Corporation Commission
800 Bittling Building
Wichita, Kansas

Reno County. Sec. 18 Twp. 24S Rge. (E) 10 (W)
Location as "NE $\frac{1}{4}$ NW $\frac{1}{4}$ SW $\frac{1}{4}$ " or footage from lines CE/2 NW/4 NE/4
Lease Owner Magnolia Petroleum Company
Lease Name Henry Sauer Well No. 1
Office Address Box 888 Ellinwood, Kansas
Character of Well (completed as Oil, Gas or Dry Hole) Dry Hole
Date, well completed May 20, 1942 193
Application for plugging filed May 20, 1942 193
Application for plugging approved May 20, 1942 193
Plugging Commenced May 20, 1942 193
Plugging Completed May 20, 1942 193
Reason for abandonment of well or producing formation Dry Hole

NORTH

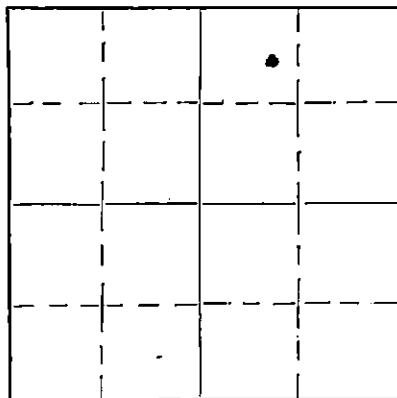

Locate well correctly on above
Section Plat

If a producing well is abandoned, date of last production 193
Was permission obtained from the Conservation Division or its agents before plugging was com-
menced? Yes

Name of Conservation Agent who supervised plugging of this well C. T. Alexander
Producing formation _____ Depth to top _____ Bottom _____ Total Depth of Well 3873 Feet
Show depth and thickness of all water, oil and gas formations.

OIL, GAS OR WATER RECORDS

CASING RECORD


Formation	Content	From	To	Size	Put In	Pulled Out
Lansing Lime	No shows	3349	3679	10-3/4"	289	none
Mississippi	No shows	3679	3708			
Kinderhook	No shows	3708	3829			
Misener Sand	No shows	3829	3840			
Viola Lime	No shows	3840	3873			

Describe in detail the manner in which the well was plugged, indicating where the mud fluid was placed and the method or methods used in introducing it into the hole. If cement or other plugs were used, state the character of same and depth placed, from 200 feet to 166 $\frac{1}{2}$ feet for each plug set.

Pumped heavy mud in hole through open end drill pipe from 3873 up to 205 feet and set bridge.

Ran 15 sacks of cement on the bridge which filled to 166 $\frac{1}{2}$ feet which is well up in the 10-3/4"

Surface Pipe which is cemented from top to bottom at 289 feet. Filled hole to top with mud and then put 6 sacks of cement at top of the pipe. Welded steel plate over the top of the surface pipe.

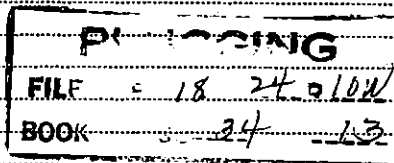

(If additional description is necessary, use BACK of this sheet)

Correspondence regarding this well should be addressed to John F. Conley, Superintendent
Address Box 888 Ellinwood, Kansas


STATE OF Kansas, COUNTY OF Reno, ss.
John F. Conley (employee of owner) or (owner or operator) of the above-described well,

being first duly sworn on oath, says: That I have knowledge of the facts, statements, and matters herein contained and the log of the above-described well as filed and that the same are true and correct. So help me God.

(Signature) John F. Conley

SUBSCRIBED AND SWORN to before me this 22 day of May

My commission expires 10-13-45

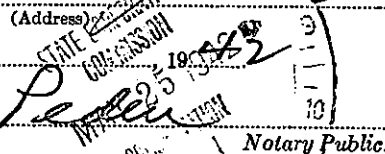

Notary Public.

15-155-01993-0000

WELL LOG - HENRY SAUER #1

Sand and Red Shale	0	to	289	10-3/4" Casing set w/ 200 Sacks
Shale and Red Bed	289		1090	
Shale and Shells	1090		1535	
Lime and shale	1535		2730	
Shale	2730		2875	
Lime	2875		3290	
Shale	3290		3349	
Top Lansing Lime-	3349		3679	
Top Missiissippi	3679		3708	
Top Kinderhook	3708		3829	
Top Misener	3829		3840	
Top Viola	3840		3873	
Total Depth	3873			
Cored	3847		3852 $\frac{1}{2}$	No shows
MEASUREMENTS CORRECTED TO GROUND LEVEL				

PLUGGING

FILE 18 24 R10W
 BOOK 34 NEL3