

15455-19003-0000

STATE OF KANSAS  
CONSERVATION COMMISSION

Give All Information Completely  
Make Required Affidavit  
Mail or Deliver Report to:  
Conservation Division  
State Corporation Commission  
800 Bittling Building  
Wichita, Kansas

WELL PLUGGING RECORD


OR

FORMATION PLUGGING RECORD

Strike out upper line  
when reporting plug-  
ging of formations.

Reno County, Sec. 11 Twp. 26S Rge. (E) 9 (W)

Location as "NE $\frac{1}{4}$ NW $\frac{1}{4}$ SW $\frac{1}{4}$ " or footage from lines. CWL SE/4  
Lease Owner Bethlehem Supply Co. (formerly Shell Oil Co., Inc.)  
Lease Name M. F. Reece Well No. 1  
Office Address Box 2171, Tulsa, Oklahoma  
Character of Well (completed as Oil, Gas or Dry Hole) Oil  
Date well completed January 10 19 37  
Application for plugging filed March 29 19 46  
Application for plugging approved April 3 19 46  
Plugging commenced February 3 19 47  
Plugging completed February 11 19 47  
Reason for abandonment of well or producing formation Oil Depleted

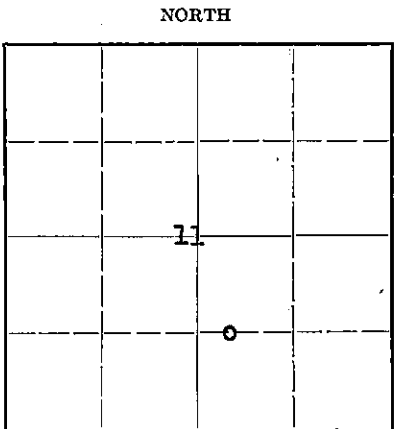

Locate well correctly on above  
Section Plat

If a producing well is abandoned, date of last production February 27 19 46  
Was permission obtained from the Conservation Division or its agents before plugging was com-  
menced? Yes

Name of Conservation Agent who supervised plugging of this well Ruel Durkee  
Producing formation Viola Depth to top 4130 Bottom          Total Depth of Well 4132 Feet  
Show depth and thickness of all water, oil and gas formations.

OIL, GAS OR WATER RECORDS

CASING RECORD

Formation	Content	From	To	Size	Put In	Pulled Out
Viola	I.P. 5060 oil & 15% water 24 hrs; St. Pot.	4130	4132	13" 7"	165' 4130'	None 2606'

Describe in detail the manner in which the well was plugged, indicating where the mud fluid was placed and the method or methods used in introducing it into the hole. If cement or other plugs were used, state the character of same and depth placed, from          feet to          feet for each plug set.

Ran 6 sacks of cement to bottom of hole. Mudded hole, set bridge at 160' and capped with 25 sacks of cement. Mudded hole & capped to base of cellar with 8 sacks of cement.

3-6-47

(If additional description is necessary, use BACK of this sheet)

Correspondence regarding this well should be addressed to Bethlehem Supply Company  
Address Box 2171, Tulsa, Oklahoma

STATE OF Kansas, COUNTY OF Barton, ss.  
J. L. Cleveland (employee of owner) or (owner or operator) of the above-described well,  
being first duly sworn on oath, says: That I have knowledge of the facts, statements, and matters herein contained and the log of the above-described well as filed and that the same are true and correct. So help me God.

(Signature) J. L. Cleveland  
Box 2171, Tulsa, Oklahoma  
(Address)

SUBSCRIBED AND SWORN to before me this 5th day of March, 19 47

Betty Postlewhite  
Notary Public.

My commission expires January 24, 1949

PLUGGING  
FILE SEC. 11 T 26 R 9W  
BOOK PAGE 49 LINE 3

15-155-19003-0000

Shell, M. F. Reece #1  
CWL SE/4 11-26S-9W  
Lorado Field  
Reno County, Kansas

CASING RECORD

13" Cem 165 with 175 sax  
7" cem 4130 with 300 sax

- 0 - 12 cellar
- 40 sand
- 50 red rock
- 210 red rock
- 410 red rock & shale
- 854 shale & shells
- 1085 shells & shale
- 1266 shale & salt
- 1387 lime & shale
- 1462 shale & gyp shells
- 1539 shale & lime shells
- 1593 broken lime
- 1748 lime & shale
- 1782 lime
- 1787 shale
- 1885 lime & shale
- 1915 lime
- 1945 shale
- 1965 lime
- 1995 shale
- 2100 lime
- 3185 shale
- 2210 lime
- 2240 shale
- 2290 lime
- 2497 broken lime
- 2558 lime
- 2695 lime & shale
- 2792 shale & lime
- 2805 lime
- 2860 shale
- 2877 lime
- 2910 shale & lime
- 2984 broken lime
- 3034 lime
- 3110 lime
- 3134 lime & shale
- 3210 lime
- 3280 lime & shale
- 3330 shale

- 4025 shale
- Top Kinderhook shale 3940
- 4054 lime shells & shale
- 4072 shale
- 4114 lime & shale
- 4121 shale
- 4123 shale & lime
- 4124 shale
- 4129 lime
- 4129-4128 SIC
- 4130 shale Top Viola 4130
- 4130<sup>1</sup>/<sub>2</sub> chert & dolomite conglomerate, pyrite
- 4132 dolomite TD

TOP LANS-KANS CITY 3330

- 3687 lime
- 3724 broken lime
- 3756 lime
- 3848 shale & lime shells
- 3860 shale
- Top Mississippi lime 3860
- 3906 chat
- 3940 lime

**PLUGGING**  
 FILE # 11-26S-9W  
 COOK. PAGE 49 LINE 3

*Ob...*  
 2-1946

Shell, M. F. Reece #1  
OIL SW/4 11-269-91  
Ierado Field  
Reno County, Kansas

CASING RECORD

13" Cem 165 with 175 sax  
7" cem 4130 with 300 sax

- 0 - 12 cellar
- 10 sand
- 50 red rock
- 210 red rock
- 410 red rock & shale
- 854 shale & shells
- 1085 shells & shale
- 1266 shale & salt
- 1387 lime & shale
- 1462 shale & gyp shells
- 1539 shale & lime shells
- 1593 broken lime
- 1748 lime & shale
- 1782 lime
- 1787 shale
- 1885 lime & shale
- 1915 lime
- 1945 shale
- 1965 lime
- 1995 shale
- 2100 lime
- 3185 shale
- 2210 lime
- 2240 shale
- 2290 lime
- 2497 broken lime
- 2558 lime
- 2695 lime & shale
- 2792 shale & lime
- 2805 lime
- 2860 shale
- 2877 lime
- 2910 shale & lime
- 2984 broken lime
- 3034 lime
- 3110 lime
- 3134 lime & shale
- 3210 lime
- 3280 lime & shale
- 3330 shale
- TOP LABS-KANS CITY 3330
- 3687 lime
- 3724 broken lime
- 3756 lime
- 3848 shale & lime shells
- 3860 shale
- TOP MISSISSIPPI LINE 3860
- 3906 chat
- 3910 lime

- 4025 shale
- Top Kinderhook shale 3910
- 4054 lime shells & shale
- 4072 shale
- 4114 lime & shale
- 4121 shale
- 4123 shale & lime
- 4124 shale
- 4129 lime
- 4129-4128 STD
- 4130 shale Top Viola 4130
- 4130, chat & dolomite conglomerate, pyrite
- 4132 dolomite TD

FIG

11 26 9 10  
49 3

