

15-047-30069-00-00

STATE OF KANSAS
STATE CORPORATION COMMISSION

Form CP-4


WELL PLUGGING RECORD

Give All Information Completely
Make Required Affidavit
Mail or Deliver Report to:
Conservation Division
State Corporation Commission
212 No. Market
Wichita, Kansas

Edwards County. Sec. 15 Twp. 25 Rge. 20W (E) (W)

Location as "NE/CNW&SW&" or footage from lines C NW NE
Lease Owner E. K. Edmiston
Lease Name ALSPAUGH Well No. -1-
Office Address 425 First National Bank Building, Wichita, Ks.
Character of Well (completed as Oil, Gas or Dry Hole) dry hole
Date well completed October 23, 1966 19
Application for plugging filed October 23, 1966 19
Application for plugging approved October 23, 1966 19
Plugging commenced October 23, 1966 19
Plugging completed October 23, 1966 19
Reason for abandonment of well or producing formation dry hole

NORTH

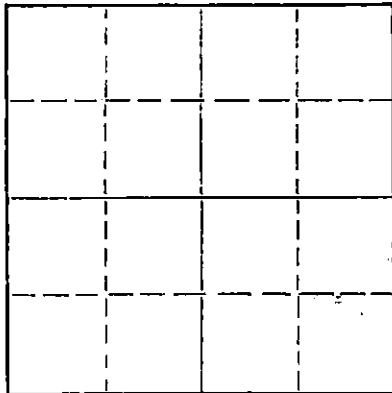

Locate well correctly on above
Section Plat

If a producing well is abandoned, date of last production --- 19
Was permission obtained from the Conservation Division or its agents before plugging was commenced? yes

Name of Conservation Agent who supervised plugging of this well Archie Elving
Producing formation --- Depth to top --- Bottom --- Total Depth of Well 4706 Feet
Show depth and thickness of all water, oil and gas formations.

OIL, GAS OR WATER RECORDS

CASING RECORD

FORMATION	CONTENT	FROM	TO	SIZE	PUT IN	PULLED OUT
				8-5/8"	267'	---

Describe in detail the manner in which the well was plugged, indicating where the mud fluid was placed and the method or methods used in introducing it into the hole. If cement or other plugs were used, state the character of same and depth placed, from --- feet to --- feet for each plug set.

plugged hole with 25 sacks cement at 250 feet,
mud to 40 feet, plugged with 10 sacks; job completed
1:30 a.m.

RECEIVED
OCT 24 1966
10-27-66
STATE CORPORATION COMMISSION
CONSERVATION DIVISION
Wichita, Kansas

(If additional description is necessary, use BACK of this sheet)

Name of Plugging Contractor E. K. Edmiston Drilling Co., Inc.
Address 425 First National Bank Building, Wichita, Kansas

STATE OF KANSAS, COUNTY OF SEDGWICK, ss.

I, E. K. Edmiston, owner of the above-described well, being first duly sworn on oath, says: That I have knowledge of the facts, statements, and matters herein contained and the log of the above-described well as filed and that the same are true and correct. So help me God.

(Signature) *E. K. Edmiston*

425 First National Bank Building
Wichita, Kansas (Address)

SUBSCRIBED AND SWORN TO before me this 26th day of October, 19 66

My commission expires August 25, 1968

A. B. Barger Notary Public.

DRILLER'S LOG

Company: E. K. Edmiston
 425 First National Bank Building
 Wichita, Kansas 67202

Rotary Drilling Commenced: October 10, 1966

Rotary Drilling Completed: October 23, 1966

Well Name: ALSPAUGH No. 1
 c NW NE 15-25S-20W
 Edwards County, Kansas

Contractor: E. K. Edmiston Drilling Co., Inc.
 425 First National Bank Building
 Wichita, Kansas 67202

Casing Record: 267' of 8-5/8" w/180 sacks Sunset cement

RECORDED
 STATE OF KANSAS
 CONSERVATION DIVISION

NOV 9 1966

CONSERVATION DIVISION
 Wichita, Kansas

L O G

Measurements from top of Kelly bushing

Shale	0 - 267
Shale	1534
Shale and Lime	2340
Lime and Shale	2965
Chalk and Lime	3460
Lime and Shale	3886
Lime	4694
Chert	4706 RTD

The undersigned, E. K. EDMISTON, President of E. K. Edmiston Drilling Co., Inc., hereby certifies on behalf of said company that the above log is a true and correct log of the formations encountered in drilling the above well, as reflected by the daily drilling reports.

E. K. EDMISTON DRILLING CO., INC.

By E. K. Edmiston
 E. K. Edmiston, President

STATE OF KANSAS,
 SS:
 SEDGWICK COUNTY,

BE IT REMEMBERED THAT on this 8th day of November, 1966, before me, the undersigned, a Notary Public within and for the county and state aforesaid, came E. K. Edmiston, known to me to be the same person who executed the foregoing instrument as President and on behalf of the E. K. Edmiston Drilling Co., Inc., and he duly acknowledged the execution of the same for himself and for said company.

IN WITNESS WHEREOF, I have hereunto set my hand and official seal on the day and year last above written.

A. B. Barga
 A. B. Barga, Notary Public

My commission expires
 August 25, 1968