


STATE OF KANSAS
STATE CORPORATION COMMISSION
200 Colorado Derby Bldg.
Wichita, Kansas 67202

Form CP-4
Rev. 12-15-80

WELL PLUGGING RECORD

Give All Information Completely
Make Required Affidavit

COUNTY Edwards SEC. 36 TWP. 25S RGE. 18W E/W
Location as in quarters or footage from lines:
SE SE SE

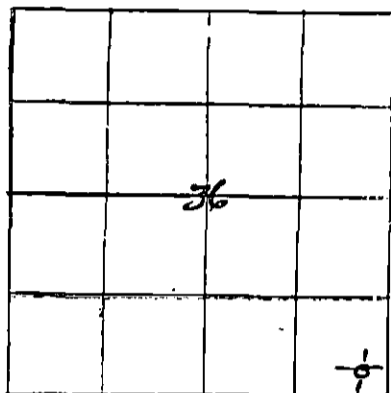

Locate Well
correctly on above
Section Platt.

Lease Owner Alpine Drilling Co., Inc.
Lease Name Derley Well No. 1
Office Address 200 East First, Suite 500, Wichita, KS 67202
Character of Well (Completed as Oil, Gas or Dry Hole): Dry Hole
Date Well Completed August 15, 1982
Application for plugging filed August 15, 1982
Plugging commenced August 15, 1982
Plugging completed August 15, 1982
Reason for abandonment of well or producing formation _____

Was permission obtained from the Conservation Division or it's
Agent's before plugging was commenced? yes

Name of Conservation Agent who supervised plugging of this well Dennis Hamell

Producing formation _____ Depth to top _____ bottom _____ T.D. 733

Show depth and thickness of all water, oil and gas formations.

OIL, GAS OR WATER RECORDS

Casing Record

Formation	Content	From	To	Size	Put in	Pulled Out
Surface	shale	0	409	8-5/8"	375	none
	cemented with	100	sx common,	2% gel,	3% cc	

Describe in detail the manner in which the well was plugged, indicating where the mud fluid was placed and the method or methods used in introducing it into the hold. If cement or other plugs were used, state the character of same and depth placed, from _____ feet to _____ feet for each plug set.

Plugged as follows: 80 sx @ 420'
10 sx @ 40'
10 sx thru d.p. in rat hole
job completed at 3:45 a.m. 8-15-82 by Halliburton


(If additional description is necessary, use BACK of this sheet)

Name of Plugging Contractor J. W. DRILLING CO., INC.

STATE OF KANSAS COUNTY OF SEDGWICK, ss.

Jon T. Williams, Jr. (employee of owner) or (owner or operator) of the above-described well, being first duly sworn on oath, says: That I have knowledge of the facts, statements, and matters herein contained and the log of the above-described well as filed and that the same are true and correct. So help me God.

(Signature) [Signature]
200 East First, Suite 500, Wichita, KS
(Address)

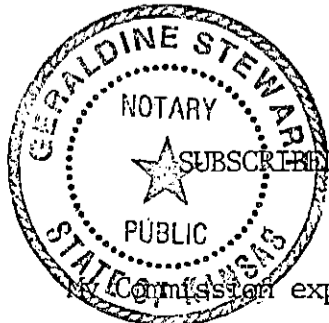

RECEIVED
AUG 26 1982
CONSERVATION DIVISION
Wichita, Kansas

Subscribed and sworn to before me this 15th day of August, 1982

Geraldine Stewart
Notary Public.
Geraldine Stewart

Commission expires: January 14, 1985