


STATE OF KANSAS
STATE CORPORATION COMMISSION

Form CP-4

WELL PLUGGING RECORD

Give All Information Completely
Make Required Affidavit
Mail or Deliver Report to:
Conservation Division
State Corporation Commission
212 No. Market
Wichita, Kansas

NORTH

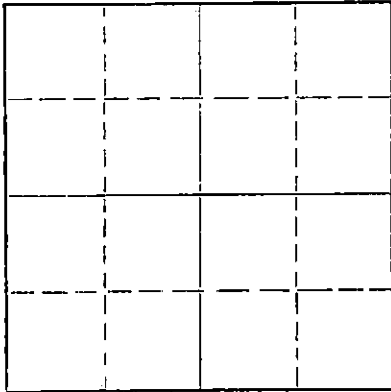

Locate well correctly on above
Section Plat

Location as "NE/CNW/SW" or footage from lines Edwards County, Sec. 36 Twp ²⁵ 15 S Rge. 18 W (E) (W)
C NE SW
Lease Owner Rupe-Stoskopf
Lease Name Derley Well No. 1
Office Address 222 Brown Building, Wichita, Kansas
Character of Well (completed as Oil, Gas or Dry Hole) Dry Hole
Date well completed 7-26-66 19
Application for plugging filed 7-26-66 19
Application for plugging approved 7-26-66 19
Plugging commenced 7-26-66 19
Plugging completed 7-26-66 19
Reason for abandonment of well or producing formation Dry Hole

If a producing well is abandoned, date of last production 19
Was permission obtained from the Conservation Division or its agents before plugging was commenced? yes

Name of Conservation Agent who supervised plugging of this well Archie Elving, Pratt, Kansas
Producing formation _____ Depth to top _____ Bottom _____ Total Depth of Well 4671 Feet
Show depth and thickness of all water, oil and gas formations.

OIL, GAS OR WATER RECORDS

CASING RECORD

FORMATION	CONTENT	FROM	TO	SIZE	PUT IN	PULLED OUT
				8 5/8"	274'	none

Describe in detail the manner in which the well was plugged, indicating where the mud fluid was placed and the method or methods used in introducing it into the hole. If cement or other plugs were used, state the character of same and depth placed, from _____ feet to _____ feet for each plug set.

Plugged to 250', pushed 1/2 sk. hulls & put 25 sks. cement through drill pipe.

Filled with mud to 40', build bridge with plug and hulls, put 10 sks. cement in hole and 2 sacks cement in rathole

RECEIVED
STATE CORPORATION COMMISSION

JUL 29 1966
7-29-66
CONSERVATION DIVISION
Wichita, Kansas

(If additional description is necessary, use BACK of this sheet)

Name of Plugging Contractor Leben Drilling, Inc.
Address Box 486, Great Bend, Kansas 67530

STATE OF KANSAS, COUNTY OF BARTON, ss.
Doug Boydte (employee of owner) or (owner or operator) of the above-described well, being first duly sworn on oath, says: That I have knowledge of the facts, statements, and matters herein contained and the log of the above-described well as filed and that the same are true and correct. So help me God.

(Signature) Doug Boydte
Box 486, Great Bend, Kansas 67530
(Address)

SUBSCRIBED AND SWORN to before me this 28th day of July, 1966

My commission expires April 1, 1967

Glenda Spitalo
Notary Public.

DRILLER'S LOG

COMPANY: Rupe-Stoskoph
 CONTRACTOR: LEBEN DRILLING, INC.
 FARM: DERLEY #1
 LOCATION: C NE SW SEC. 36-²⁵SS-18W
 EDWARDS COUNTY, KANSAS
 COMMENCED: 7-14-66
 COMPLETED: 7-26-66

0	185	Sand, Shale
185	275	Gray Shale
275	1000	Shale, Redbed
1000	1236	Shale
1236	1250	Anhydrite
1250	2420	Shale
2420	2570	Shale, Lime Streaks
2570	2790	Shale, Lime
2790	3145	Lime, Shale
3145	3275	Shale, Sandy Lime
3275	3496	Shale, Lime
3496	3850	Lime, Shale
3850	3955	Lime
3955	4156	Lime, Shale
4156	4515	Lime
4515	4747	Lime, Chert Streaks
4747	4590	Lime
4590	4671	Lime, Chert
	<u>4671</u>	<u>RTD. - D. & A.</u>


Set 8 5/8" used surface casing @ 274' cemented with 225 sacks
 Common, 2% cc, 3% Gel

I, Doug Boyd, do hereby certify that the above and foregoing is a true and correct copy of the log of the Derley #1 well, located C NE SW of Section 36, Township 15 South, Range 18 West, Edwards County, Kansas, as reflected by the records of Leben Drilling, Inc.

Doug Boyd
 Doug Boyd

STATE OF KANSAS)
) SS
 COUNTY OF BARTON)

Subscribed and sworn to and before me, a Notary Public, in and for Barton County, Kansas, this 28th day of July, 1966.

Ulanda Nichols
 Ulanda Nichols

My Commission Expires:
 April 1, 1967