

STATE OF KANSAS
STATE CORPORATION COMMISSION

Give All Information Completely
Make Required Affidavit
Mail or Deliver Report to:
Conservation Division
State Corporation Commission
211 No. Broadway
Wichita, Kansas

WELL PLUGGING RECORD

Edwards County, Sec. 32 Twp. 25 Rge. 17 (E) W (W)

Location as "NE/CNW/SW" or footage from lines. NE/4 C NENE

Lease Owner Apex Supply, Inc.

Lease Name Smith Well No. 1

Office Address Great Bend, Kansas

Character of Well (completed as Oil, Gas or Dry Hole)

Date well completed 19

Application for plugging filed 19

Application for plugging approved 19


Plugging commenced 5-23-61 19

Plugging completed 5-25-61 19

Reason for abandonment of well or producing formation Depleted.

If a producing well is abandoned, date of last production 19

Was permission obtained from the Conservation Division or its agents before plugging was commenced? yes

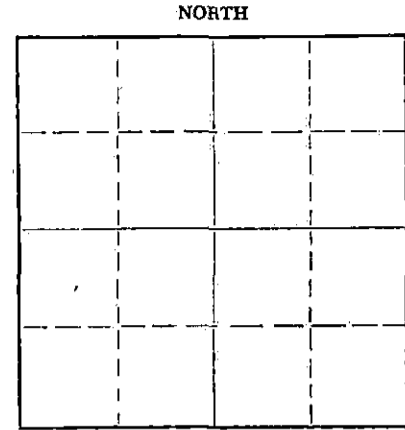

Locate well correctly on above Section Plat

Name of Conservation Agent who supervised plugging of this well Frank Broadfoot

Producing formation Depth to top Bottom Total Depth of Well 4560 Feet

Show depth and thickness of all water, oil and gas formations.

OIL, GAS OR WATER RECORDS

CASING RECORD

FORMATION	CONTENT	FROM	TO	SIZE	PUT IN	PULLED OUT
				8-5/8"	228'	None
				5-1/2"	4503	3879'

Describe in detail the manner in which the well was plugged, indicating where the mud fluid was placed and the method or methods used in introducing it into the hole. If cement or other plugs were used, state the character of same and depth placed, from feet to feet for each plug set.

Checked hole to 4560', ran sand from 4560' to 4490' and dumped 5 sacks of cement @ 4490' with dump bailer. Pulled 5 1/2" casing, mudded hole to 220', set 10' rock bridge to 210' and ran 20 sacks of cement @ 210'. Mudded to 40', set rock bridge to 30' and ran 10 sacks of cement to base of cellar.

PLUGGING COMPLETE.

RECEIVED
STATE CORPORATION COMMISSION

JUN 1 1961
6-1-61
CONSERVATION DIVISION
Wichita, Kansas

(If additional description is necessary, use BACK of this sheet)

Name of Plugging Contractor KNIGHT CASING PULLING CO.

Address CHASE, KANSAS

STATE OF KANSAS COUNTY OF RICE, ss.

Noel J. Knight (employee of owner) or (owner) of the above-described well, being first duly sworn on oath, says: That I have knowledge of the facts, statements, and matters herein contained and the log of the above-described well as filed and that the same are true and correct. So help me God.

(Signature) Noel J. Knight
Chase, Kansas
(Address)

SUBSCRIBED AND SWORN TO, before me this 26th day of May, 19 61

My commission expires May 20, 1964 Notary Public.



BARNETT DRILLING, INC.

LOG OF SMITH WELL NO. 1

C NE $\frac{1}{4}$ SECTION 32-25S-17W, EDWARDS COUNTY, KANSAS

Commenced: 8-21-54

Completed: 8-6-54

<u>Formation</u>	<u>From</u>	<u>To</u>	<u>Remarks</u>
Clay	0	75	
Sandy Clay	75	165	
Sand	165	190	
Blue Shale	190	228	Set 8-5/8" surface pipe at 228 feet, cemented with 200 sacks.
Shale	228	450	
Sand and Shale	450	550	
Red Shale and Shells	550	1170	
Anhydrite	1170	1195	
Shale and Shells	1195	1780	
Shale and Lime	1780	2355	
Lime	2355	2505	
Lime and Shale	2505	2626	
Lime	2626	2790	
Shale and Lime	2790	2905	
Lime	2905	2930	
Lime and Shale	2930	3130	
Lime	3130	3205	
Lime and Shale	3205	3335	
Lime	3335	3510	
Lime and Shale	3510	3720	
Lime	3720	3935	
Lime and Shale	3935	3995	
Lime	3995	4225	
Lime and Shale	4225	4260	
Lime	4260	4340	
Lime and Shale	4340	4395	
Lime	4395	4505	
Total Depth		4505	Set 5 1/2" casing at 4503 feet.

CERTIFICATE

I, F. R. Stubblefield, of Barnett Drilling, Inc., certify that, to the best of my knowledge and belief, the above is a true and correct log of the Smith Well No. 1, located in the Center of the Northeast Quarter (C NE $\frac{1}{4}$) of Section 32-25S-17W, Edwards County, Kansas.

F. R. Stubblefield

Subscribed and sworn to before me, in and for the County of Sedgwick, State of Kansas, this 13th day of September, 1954.

Miller J. Willis

My commission expires February 27, 1956.

