


15-155-00048-0000

STATE OF KANSAS
STATE CORPORATION COMMISSION

WELL PLUGGING RECORD

Give All Information Completely
Make Required Affidavit
Mail or Deliver Report to:
Conservation Division
State Corporation Commission
800 Bittig Building
Wichita, Kansas

Reno County. Sec. 35 Twp. 24S Rge. 5W (E) (W)
Location as "NE/CNW/SW 1/4" or footage from lines SE SE NW
Lease Owner Francis Oil & Gas, Inc.
Lease Name Keim Well No. 1
Office Address 902 Palace Building, Tulsa, Oklahoma
Character of Well (completed as Oil, Gas or Dry Hole) Dry Hole
Date well completed 3-30 19 51
Application for plugging filed 3-30 19 51
Application for plugging approved 3-30 19 51
Plugging commenced 9:00 P.M. 3-30 19 51
Plugging completed 11:00 P.M. 3-31 19 51
Reason for abandonment of well or producing formation Commercial quantity of oil not found.
If a producing well is abandoned, date of last production -- 19 --
Was permission obtained from the Conservation Division or its agents before plugging was commenced? Yes

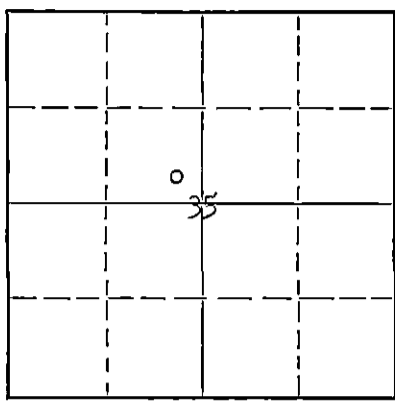

Locate well correctly on above
Section Plat

Name of Conservation Agent who supervised plugging of this well Mr. Durkee
Producing formation -- Depth to top -- Bottom -- Total Depth of Well -- Feet
Show depth and thickness of all water, oil and gas formations.

OIL, GAS OR WATER RECORDS

CASING RECORD

Formation	Content	From	To	Size	Put In	Pulled Out
				8 5/8"	507'	None

Describe in detail the manner in which the well was plugged, indicating where the mud fluid was placed and the method or methods used in introducing it into the hole. If cement or other plugs were used, state the character of same and depth placed, from -- feet to -- feet for each plug set.

Filled hole with heavy mud. Set wooden plug at 250'. Pumped in 15 Sx. of cement and then capped with wooden plug and 5 Sx. cement.

REC'D
STATE CORP. COM.
APR 3 1951 4-3-51
CONSERVATION DIVISION
Wichita, Kansas


(If additional description is necessary, use BACK of this sheet)
Correspondence regarding this well should be addressed to Francis Oil & Gas, Inc.
Address 902 Palace Building, Tulsa, Oklahoma

STATE OF KANSAS, COUNTY OF SEDGWICK ss.
Clinton Engstrand, agent for owner (employee of owner) or (owner or operator) of the above-described well,
being first duly sworn on oath, says: That I have knowledge of the facts, statements, and matters herein contained and the log of the above-described well as filed and that the same are true and correct. So help me God.

(Signature) *Clinton Engstrand*
1006 Central Building
(Address)

SUBSCRIBED AND SWORN TO before me this 2nd day of April, 19 51
[Signature]
Notary Public.

My commission expires 6-5-51

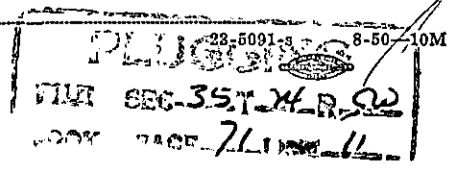

FRANCIS OIL & GAS, INC.
KEIM # 1

SE SE NW Sec. 35-24S-5W
Reno County, Kansas

Total Depth: 3950'
Comm: 3-9-51
Comp: 3-30-51

Casing 8 5/8" Set @ 507'
Cement 225 Sacks

<u>Formation</u>	<u>Depth</u>
Surface soils, clays and water sand	0 - 100
Sand & shale	100 - 200
Shale	200 - 325
Shale & shells	325 - 507
Anhydrite	507 - 650
Shale & shells	650 - 835
Shale, lime & salt	835 - 935
Shale & shells	935 - 1185
Shale & lime	1185 - 1475
Shale & shells	1475 - 1600
Shale & lime	1600 - 1795
Shale & shells	1795 - 1940
Shale & lime	1940 - 2440
Sandy lime & shale	2440 - 2575
Sandy lime	2575 - 2649
Shale & Lime	2649 - 2760
Lime	2760 - 2815
Lime & shale	2815 - 2860
Lime & sandy shale	2860 - 2905
Lime & shale	2905 - 3395
Lime & chert	3395 - 3473
Lime	3473 - 3495
Lime & chert	3495 - 3536
Lime & shale	3536 - 3550
Cherty lime & shale	3550 - 3575
Lime	3575 - 3605
Lime & shale	3605 - 3760
Cherty lime & shale	3760 - 3785
Lime & shale	3785 - 3825
Lime & sand	3825 - 3846
Sand & shale	3846 - 3850
" "	2850 - 3865
" "	3865 - 3928
Lime	3928 - 3950

Total Depth 3950'

STATE OF KANSAS)
) SS
SEDGWICK COUNTY)

PLUGGING
FILE SEC 35-24-R52
ROCK PAGE 76 LINE 11

RECEIVED
STATE CORPORATION COMMISSION
APR 7 1951 4-7-51

I hereby certify that the above information is true and correct to the best of my knowledge.

[Handwritten Signature]

Subscribed and sworn to before me this 3rd day of April, 1951.

[Handwritten Signature]

My commission expires: 6-5-54