


STATE OF KANSAS
STATE CORPORATION COMMISSION
Give All Information Completely
Make Required Affidavit
Mail or Deliver Report to:
Conservation Division
State Corporation Commission
211 No. Broadway
Wichita, Kansas

WELL PLUGGING RECORD

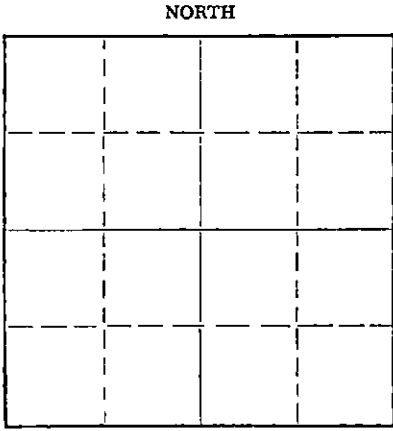

Locate well correctly on above Section Plat

Reno County. Sec. 36 Twp. 24S Rge. (E) 5(W)
Location as "NE/CNW/SW" or footage from lines SE SE NW
Lease Owner Leben Drilling, Inc.
Lease Name Gilmore Well No. 1
Office Address 905 Central Building, Wichita, Kansas
Character of Well (completed as Oil, Gas or Dry Hole) _____
Date well completed _____ 19____
Application for plugging filed October 27 19 56
Application for plugging approved October 27 19 56
Plugging commenced October 27 19 56
Plugging completed October 27 19 56
Reason for abandonment of well or producing formation Surface Pipe parted at 1186'
If a producing well is abandoned, date of last production _____ 19____
Was permission obtained from the Conservation Division or its agents before plugging was commenced? Yes

Name of Conservation Agent who supervised plugging of this well M. A. Rives
Producing formation _____ Depth to top _____ Bottom _____ Total Depth of Well 1186 Feet
Show depth and thickness of all water, oil and gas formations.

OIL, GAS OR WATER RECORDS

CASING RECORD

FORMATION	CONTENT	FROM	TO	SIZE	PUT IN	PULLED OUT
				8 5/8	580'	

Describe in detail the manner in which the well was plugged, indicating where the mud fluid was placed and the method or methods used in introducing it into the hole. If cement or other plugs were used, state the character of same and depth placed, from _____ feet to _____ feet for each plug set.

Set first plug at 500' w/20 sacks of cement - second plug at 35' and cemented to surface with 10 sacks cement.

(If additional description is necessary, use BACK of this sheet)
Name of Plugging Contractor Leben Drilling, Inc.
Address 905 Central Building, Wichita, Kansas

STATE OF Kansas, COUNTY OF Sedgwick, ss.
James M. Battin (employee of owner) of ~~Kansas~~ of the above-described well, being first duly sworn on oath, says: That I have knowledge of the facts, statements, and matters herein contained and the log of the above-described well as filed and that the same are true and correct. So help me God.

(Signature) James M. Battin
905 Central Building, Wichita, Ks.
(Address)

SUBSCRIBED AND SWORN to before me this 30th day of October, 19 56

My commission expires July 11, 1957

James M. Battin Notary Public.

PLUGGING
FILE SEC. 36 T. 24 R. 5W
BOOK PAGE 111 L. E. 9

RECEIVED
STATE CORPORATION COMMISSION
OCT 31 1956
10-31-56
CONSERVATION DIVISION
Wichita, Kansas

CONTRACTOR'S WELL LOG

Leben Drilling, Inc.
Gilmore #1
SE SE NW of Sec. 36-24S-5W
Reno County, Kansas

0	280	Clay and Shells	COMMENCED: October 23, 1956
280	510	Shale and Lime Shells	
510	581	Shale and Shells	
581	650	Shale and Shells	ABANDONED: October 27, 1956
650	716	Shale and Shells	
716	734	Anhydrite	
734	885	Shale and Lime	SURFACE CASING:
885	1050	Shale and Lime	Set 8 5/8" at 580' w/200
1050	1185	Shale and Lime	sacks cement plus 6 sacks
1185	1186	Shale and Lime	Ca. Cl.
	1186	<u>Surface Pipe Parted</u>	

State of Kansas)
County of Sedgwick) ss:

I, James M. Battin, do hereby certify that the above and foregoing is a true and correct copy of the log of the Gilmore #1, SE SE NW of Section 36-24S-5W, Reno County, Kansas, as reflected by the files of Leben Drilling, Inc..

James M. Battin
James M. Battin

Subscribed and Sworn to before me, a Notary Public, in and for Sedgwick County, Kansas, this 29th day of October, 1956.

John Thomas

My commission expires July 10, 1957.

PLUGGING
FILE SEC. 26 T. 24 R. 5W
BOOK PAGE 111 LINE 9

RECEIVED 10-31-56
STATE CORPORATION COMMISSION
OCT 31 1956
CONSERVATION DIVISION
Wichita, Kansas