


STATE OF KANSAS
STATE CORPORATION COMMISSION

Give All Information Completely
Make Required Affidavit
Mail or Deliver Report to:
Conservation Division
State Corporation Commission
800 Bittling Building
Wichita, Kansas

WELL PLUGGING RECORD

NORTH

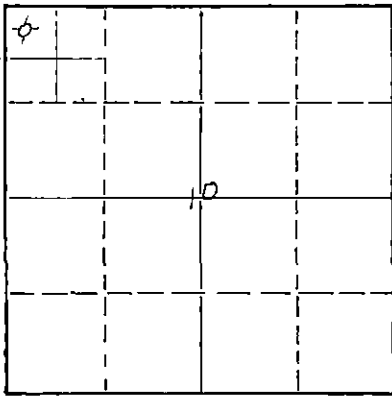

Locate well correctly on above
Section Plat

Reno County, Sec. 10 Twp. 24 Rge. (E) 6 (W)
Location as "NE/CNW/SW" or footage from lines NW/4 NW/4 NW/4
Lease Owner T & M Oil Company
Lease Name Haines Well No. 1
Office Address 900 East 21st Street, Wichita 4, Kansas
Character of Well (completed as Oil, Gas or Dry Hole) Dry Hole
Date well completed December 12 19 55
Application for plugging filed December 12 19 55
Application for plugging approved December 12 19 55
Plugging commenced December 13 19 55
Plugging completed December 13 19 55
Reason for abandonment of well or producing formation Dry Hole

If a producing well is abandoned, date of last production 19
Was permission obtained from the Conservation Division or its agents before plugging was commenced? Yes

Name of Conservation Agent who supervised plugging of this well Ruel Durkee
Producing formation Arbuckle Depth to top 4149 Bottom --- Total Depth of Well 4171 Feet
Show depth and thickness of all water, oil and gas formations.

OIL, GAS OR WATER RECORDS

CASING RECORD

FORMATION	CONTENT	FROM	TO	SIZE	PUT IN	PULLED OUT
				8 5/8"	170'	None

Describe in detail the manner in which the well was plugged, indicating where the mud fluid was placed and the method or methods used in introducing it into the hole. If cement or other plugs were used, state the character of same and depth placed, from feet to feet for each plug set.

4171 - 160 Heavy Rotary Mud
160 - 120 Rock Bridge, 15 sacks cement
120 - 30 Heavy Rotary Mud
30 - Surface Rock Bridge and 5 sacks cement.

(If additional description is necessary, use BACK of this sheet)

Name of Plugging Contractor Thos. H. Allan
Address 1221 Union National Bank Building, Wichita 2, Kansas

STATE OF KANSAS, COUNTY OF SEDGWICK, ss.
Thos. H. Allan (employee of owner) or (owner or operator) of the above-described well, being first duly sworn on oath, says: That I have knowledge of the facts, statements, and matters herein contained and the log of the above-described well as filed and that the same are true and correct. So help me God.

(Signature) Thos. H. Allan
1221 Union National Bank Bldg., Wichita 2, Kansas
(Address)

SUBSCRIBED AND SWORN TO before me this 16th day of December, 19 55

My commission expires June 14, 1958

Ocie M. Stewart
Notary Public.

PLUGGING
FILE DEC 10 11 34 AM '55
BOOK PAGE 25 LINE 18

DEC 20 1955 12-20-55
CONSERVATION DIVISION
Wichita, Kansas

8 5/8" @ 170' - 140 Sx - Circ

T & M Oil Co. - #1 HAINES
NW NW NW 10-24-6W
Reno County, Kansas
COMM: 11/23/55 COMPL: 12/13/55
CONTRACTOR: Tom Allan
ELEV: 1559 RB

I.P. D & A

All Depths from Rotary Bushings

- 0 - 17 Soil
- 50 Sand
- 90 Yellow Clay
- 170 Red Beds
- 500 Red Rock
- 600 Shale
- 1000 Salt & Shale
- 1200 Anhydrite & Shale
- 1300 Shale
- 1400 Lime
- 1800 Shale & Shells
- 2100 Shale
- 2400 Shale & Shells
- 2750 Lime
- 2758 Black Shale
- 2790 Sandy Shale
- 2815 Lime
- 2941 Sand
- 2947 Lime Brown
- 2969 Shale
- 3125 Lime
- 3132 Shale
- 3166 Lime
- 3172 Shale
- 3179 Oolitic Lime
- 3211 Lime
- 3238 Shale & Limy Shale
- 3270 Lime
- 3274 Black Shale
- 3288 Shale
- 3322 Lime
- 3335 Shale & Shells
- 3345 Oolitic Lime
- 3357 Lime
- 3390 Shale
- 3410 Lime
- 3435 Varicolor Shale
- 3446 Lime
- 3463 Shale
- 3481 Lime
- 3538 Shale
- 3585 Vari Color Shale
- 3595 Lime
- 3608 Vari Color Shale

- 3626 Lime & Shale
- 3632 Vari Color Shale
- 3657 Weathered Chert
- 3747 Wht. Chert & Cherty Lime
- 3757 Cherty Dolomite
- 3767 Green Shale
- 3802 Fine Chrystaline Lime
- 3970 Gray Green Shale
- 4030 Dolomitic Shale
- 4035 Shaley Dolomite
- 4064 Wht. coarse Chryst. Lime
- 4120 Dolomitic Sandstone
- 4149 Shaley Dolomite & Sand
- 4171 Dolomite
- D.S.T. - 4063-4080
- 17' Mud/l hour - BHP 1055#/30 Min.
- T.D. 4171 = 4172 Schlumberger Elec. Log

FORMATION TOPS

- 2750 Heebner
- 2941 Brown Lime
- 2969 Lansing
- 3538 Conglomerate Shale
- 3632 Mississippi
- 3802 Kinderhook
- 3970 Maquoketa
- 4035 Viola
- 4064 Simpson
- 4149 Arbuckle

I certify that the above is a true and correct copy of the well log on the above test.

Tom Allan
CONTRACTOR

STATE CLERK

DEC 20 1955

CONSERVATION DIVISION
Wichita, Kansas

12-20-55

Subscribed and sworn to before me this 16th day of December, 1955

Ocie M. Stewart
Notary Public

My Commission expires June 14, 1958

PLUGGING
FILE SEC 10 134 R 6W
PAGE 25 LINE 18