


STATE OF KANSAS
STATE CORPORATION COMMISSION

Give All Information Completely
Make Required Affidavit
Mail or Deliver Report to:
Conservation Division
State Corporation Commission
211 No. Broadway
Wichita, Kansas

WELL PLUGGING RECORD

NORTH

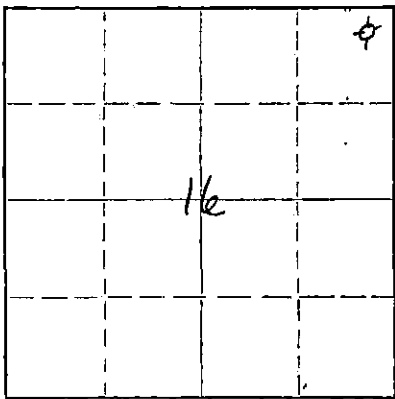

Locate well correctly on above
Section Plat

Reno County. Sec. 16 Twp. 24 Rge. 6 (W)
Location as "NE/CNW4SW4" or footage from lines. NE NE NE
Lease Owner. T & M Oil Company
Lease Name. Stewart Well No. 1
Office Address. 900 East 21st Street, Wichita 4, Kansas
Character of Well (completed as Oil, Gas or Dry Hole) Dry Hole
Date well completed April 12 19 56
Application for plugging filed April 12 19 56
Application for plugging approved April 12 19 56
Plugging commenced April 12 19 56
Plugging completed April 12 19 56
Reason for abandonment of well or producing formation Dry Hole

If a producing well is abandoned, date of last production. 19
Was permission obtained from the Conservation Division or its agents before plugging was commenced? Yes

Name of Conservation Agent who supervised plugging of this well Ruel Durkee
Producing formation Arkuckle Depth to top 4167 Bottom Total Depth of Well 4199 Feet
Show depth and thickness of all water, oil and gas formations.

OIL, GAS OR WATER RECORDS

CASING RECORD

FORMATION	CONTENT	FROM	TO	SIZE	PUT IN	PULLED OUT
				8 5/8"	208	none

Describe in detail the manner in which the well was plugged, indicating where the mud fluid was placed and the method or methods used in introducing it into the hole. If cement or other plugs were used, state the character of same and depth placed, from feet to feet for each plug set.

4199 - 200 Heavy rotary mud
200 - 190 Rock Bridge
190 - 60 15 sacks of cement
60 - 30 Heavy rotary mud
30 - Surface Bridge and 5 sacks cement

(If additional description is necessary, use BACK of this sheet)

Name of Plugging Contractor Thos. H. Allan
Address 1221 Union National Bank Building, Wichita 2, Kansas

STATE OF KANSAS, COUNTY OF SEDGWICK, ss.
Thos. H. Allan (employee of owner) or (owner or operator) of the above-described well, being first duly sworn on oath, says: That I have knowledge of the facts, statements, and matters herein contained and the log of the above-described well as filed and that the same are true and correct. So help me God.

(Signature) Thos. H. Allan
1221 Union Nat'l Bk. Building, Wichita 2, Kansas
(Address)

SUBSCRIBED AND SWORN TO before me this 16th day of April, 19 56
Ocie M. Stewart
Notary Public.

My commission expires June 14, 1958

PLUGGING
FILE SEC. 16 T 24 R 6W
BOOK PAGE 54 LINE 14

APR 19 56
CONSERVATION DIVISION
WICHITA, KANSAS
4-17-56

15-155-00029-0000

8 5/8" @ 208' - 170 cu. ft.
pozmix circ.

T & M OIL - #1 STEWART
NE NE NE 16-24-6W
Reno County, Kansas
COMM: 3/26/56 COMPL: 4/12/56
CONTRACTOR: Tom Allan
ELEV: 1563 RB

I.P. D & A

All Depths from Rotary Bushings

0 - 18 Soil
26 Sand
75 Yellow Clay
208 Red & Green Shale
450 Red Beds
650 Shale
950 Salt & Shale
1150 Anhydrite & Shale
1250 Shale
1500 Lime
1850 Shale & Shells
2300 Shale
2740 Lime
2775 Shale
2790 Lime
2796 Black Shale
2920 Sandstone
2950 Shale
2964 Sandstone
2974 Brown Lime
2994 Shale
3255 Lime
3275 Shale
3315 Lime
3335 Shale
3395 Lime
3540 Shale
3655 Vari Color Shale
3676 Red Shale & Chert
3787 White Chert
3830 Cherty Lime
4005 Gray Shale
4014 Sandy Dolomite
4020 Hard Pyritic Sandstone
4054 Dolomitic Shale
4085 White Chrystalline Lime
4115 Cherty Sandy Dolomite
4138 Hard Sandstone
4167 Sandy Shale
4199 (T.D.) Cherty Dolomite

FORMATION TOPS

2790 Heebner
2964 Brown Lime
2994 Lansing
3676 Mississippi Chert
3830 Kinderhook
4014 Misner Sand
4020 Maquoketa
4054 Viola
4085 Simpson
4167 Arbuckle

I certify that the above is a true and correct copy of the well log on the above test.

Thomas H. Allan

Subscribed and sworn to before me this 16th day of April, 1956

Ocie M. Stewart
Notary Public

My Commission expires June 14, 1958.

4-17-56

